



CRESTONE PEAK RESOURCES MIDSTREAM LLC
SECTIONS 19, 20, 29, 30, 32, 33, & 34, TOWNSHIP 3 SOUTH, RANGE 64 WEST, SECTIONS 13, 15, 22, 23, 24, 25, 26, 27, 33, & 34, TOWNSHIP 3 SOUTH, RANGE 65 WEST, OF THE SIXTH PRINCIPAL MERIDIAN, CITY OF AURORA, ADAMS COUNTY, STATE OF COLORADO
SECTIONS 3, 15, 17, 20, 21, 22, 25, 26, 27 & 28, TOWNSHIP 4 SOUTH, RANGE 65 WEST, SECTIONS 18, 19 & 30, TOWNSHIP 4 SOUTH, RANGE 64 WEST OF THE SIXTH PRINCIPAL MERIDIAN, CITY OF AURORA, ARAPAHOE COUNTY, STATE OF COLORADO

1. TOTAL LENGTH OF GATHERING SYSTEM = 33 MILES.
2. ALL INTERESTED PARTIES ARE HEREBY ALERTED THAT THIS SITE PLAN IS SUBJECT TO ADMINISTRATIVE CHANGES AND AS SHOWN ON THE ORIGINAL SITE PLAN ON FIELD IN THE AURORA CITY PLANNING OFFICE AT THE MUNICIPAL BUILDING. A COPY OF THE OFFICIAL CURRENT PLAN MAY BE PURCHASED THERE. LIKEWISE, SITE PLANS ARE REQUIRED TO AGREE WITH THE APPROVED SUBDIVISION PLAT OF RECORD AT THE TIME OF A BUILDING PERMIT; AND IF NOT MUST BE AMENDED TO AGREE WITH THE PLAT AS NEEDED, OR VICE VERSA.
3. ERRORS IN APPROVED SITE PLANS RESULTING FROM COMPUTATIONS OF INCONSISTENCIES IN THE DRAWINGS MADE BY THE APPLICANT ARE THE RESPONSIBILITY OF THE APPLICANT OF RECORD. WHERE FOUND, THE CURRENT MINIMUM CODE REQUIREMENTS WILL APPLY AT THE TIME OF BUILDING PERMIT. PLEASE BE SURE THAT ALL PLAN COMPUTATIONS ARE CORRECT.
4. ALL REPRESENTATIONS AND COMMITMENTS MADE BY APPLICANT AT PUBLIC HEARINGS, REGARDING THIS PLAN, ARE BINDING UPON THE APPLICANT, AND ITS HEIRS, SUCCESSORS, AND ASSIGNS.
5. THE CITY OF AURORA REQUIRES PLAN AND PROFILES (P&P) OF THE PROPOSED PIPELINE AT CITY OF AURORA RIGHTS-OF-WAY AND EASEMENTS WITH ALL LICENSE AGREEMENTS AND CIVIL PLAN SUBMITTALS. THE P&PS SHALL SHOW ALL EXISTING AND KNOWN PROPOSED UTILITIES WITH VERIFIED ELEVATIONS BASED ON PRE-DESIGN POT-HOLING AND DEMONSTRATE THE REQUIRED MINIMUM HORIZONTAL AND VERTICAL UTILITY CLEARANCES ARE BEING MET.
6. AS-BUILT DRAWINGS SHALL BE PROVIDED TO THE CITY OF AURORA WITHIN 30 DAYS OF FINAL CONSTRUCTION IN A FORMAT THAT MEETS THE LATEST CITY OF AURORA CAD DATA SUBMITTAL STANDARDS.
7. PIPELINES CONSTRUCTED THROUGH COLLECTORS OR LOCALS SHALL PROVIDE 15' OF COVER MINIMUM, UNLESS OTHERWISE STATED ON PLANS. IF A CROSSING WILL NOT MEET MINIMUM COVER, A VARIANCE REQUEST WILL BE REQUIRED.
8. PIPELINES CONSTRUCTED THROUGH ARTERIALS SHALL PROVIDE 20' OF COVER MINIMUM, UNLESS OTHERWISE STATED ON PLANS. IF A CROSSING WILL NOT MEET MINIMUM COVER, A VARIANCE REQUEST WILL BE REQUIRED.
9. DISTURBED GROUND IS TO BE RETURNED TO EXISTING ELEVATIONS.
10. IN THE EVENT GROUNDWATER IS ENCOUNTERED DURING PIPELINE CONSTRUCTION, CONTRACTOR OR SHALL NOTIFY THE CITY OF AURORA AND BE PREPARED TO REPORT THE LOCATION AND DEPTH OF THE GROUNDWATER. ADDITIONALLY, IF DEWATERING OF THE TRENCH IS NECESSARY, A DEWATERING PERMIT FROM COLORADO DEPARTMENT OF PUBLIC HEALTH AND ENVIRONMENT MAY BE REQUIRED.
11. A FLOODPLAIN DEVELOPMENT PERMIT IS REQUIRED FOR ALL WORK WITHIN A FEMA DESIGNATED FLOODPLAIN.
12. UPON REMOVING A GATHERING SYSTEM OR FLOWLINE FROM SERVICE, ALL SEGMENTS MUST BE REMOVED OR ABANDONED IN PLACE USING FLOWFILL OR SIMILAR.
13. ALL AMENDMENTS TO THIS SITE PLAN SHALL UTILIZE EASEMENTS THAT DO NOT SIGNIFICANTLY ENCUMBER CURBSIDE LANDSCAPING OR STREET FRONTAGE LANDSCAPE BUFFERS FOR FUTURE DEVELOPMENTS. THIS CAN BE DONE BY EITHER LOCATING ALL EASEMENTS OUTSIDE OF THESE IDENTIFIED AREAS OR INCLUDING EASEMENT LANGUAGE THAT ALLOWS SUFFICIENT PLANTINGS (AS DETERMINED BY THE CITY LANDSCAPE ARCHITECT) TO BE INSTALLED WITHIN EASEMENTS.
14. THE GATHERING SYSTEM AND FLOWLINE WILL NOT HAVE ANY UNDUE ADVERSE EFFECTS ON EXISTING AND FUTURE DEVELOPMENT OF THE SURROUNDING AREA AS SET FORTH IN APPLICABLE CITY MASTER PLANS. THE DESIGN OF THE PROPOSED GATHERING SYSTEM AND FLOWLINE MITIGATES NEGATIVE IMPACTS ON THE SURROUND AREA TO THE GREATEST EXTENT FEASIBLE. THE DISTURBED AREA SHALL BE MAINTAINED DURING CONSTRUCTION BY THE APPLICANT OR PROPERTY OWNER IN SUCH A MANNER TO CONTROL SOIL EROSION, DUST AND THE GROWTH OF NOXIOUS WEEDS.
15. THE MILE HIGH FLOOD DISTRICT WILL CONDUCT SITE VISITS DURING THE PROJECT CONSTRUCTION WITHIN OR NEAR THE CHANNEL AND FLOODPLAIN AREAS TO OBSERVE CONSTRUCTION FOR CONFORMANCE WITH THE APPROVED PLANS AND SPECIFICATIONS. PLEASE CONTACT MHFD (303-455-6277) TO SCHEDULE A PRECONSTRUCTION MEETING. ALL CONSTRUCTION ACTIVITIES WITHIN THE FLOODPLAIN LIMITS REQUIRE 48-HOURS' NOTICE. STANDARDS AND SPECIFICATIONS FOR ALL OUTFALL AND CHANNEL WORK CAN BE ACCESSED AT WWW.MHFD.ORG UNDER THE REFERENCES SECTION. FAILURE TO NOTIFY MAY RESULT IN PROJECT INELIGIBILITY.

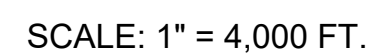

1 - COVER SHEET
2 - CITY OF AURORA LIMITS & ZONING
3 - CITY OF AURORA NEIGHBORHOOD MAP
4 - APPURTENANCE SITE & FEMA FLOODPLAIN MAP
5 - SPINE A SOUTH 0+00 TO 80+61, LINE 6 0+00 TO 2+50, WATKINS 19-1 LATERAL & MONTEZUMA LATERAL
6 - LINE 6 2+50 TO 137+50, LUSSING TRUST LATERAL 0+00 TO 5+00, & WATKINS 30-5 LATERAL 0+00 TO 2+50
7 - LUSSING TRUST LATERAL 5+00 TO 29+68 & WATKINS 30-5 LATERAL 2+50 24+58
8 - LINE 6 137+50 TO 230+89 & RUSH SOUTH LATERAL 0+00 TO 4+50
02-08-21 9 - RUSH SOUTH LATERAL 4+50 TO 52+50 & GRANDE SOUTH LATERAL 0+00 TO 5+00 & RUSH NORTH LATERAL 0+00 TO 4+50
10 - GRANDE SOUTH LATERAL 5+00 TO 50+42 & EASTERN HILLS NORTH LATERAL 5+50 TO 27+50 & GRANDE NORTH 0+00 TO 1+50
08-10-21 11 - EASTERN HILLS NORTH LATERAL 27+50 TO 75+58
12 - SPINE G SOUTH 2+00 TO 51+35, CHICO LATERAL, & COTTONWOOD CREEK LATERAL 0+00 TO 15+71
13 - SPINE G NORTH 2+00 TO 101+50, SUNSET GRIMM MOTOCROSS LATERAL, & LONE TREE NORTH LATERAL
14 - SPINE G NORTH 101+50 TO 222+50, PROPERTY RESERVE PAD 1 LATERAL, & PROPERTY RESERVE PAD 2 LATERAL
15 - SPINE G NORTH 222+50 TO 303+05 BLUE LATERAL 0+00 TO 14+30, ASPEN, BEAR, FLORIDA LINE 0+00 TO 1+50, & SPINE G WATERLINE/MUSTANG STATION LATERALS
05-04-21 16 - ASPEN, BEAR, FLORIDA LINE 1+50 TO 56+50, KING LATERAL, FLORIDA LATERAL, & LINE 7 0+00 TO 2+00
17 - ASPEN, BEAR, FLORIDA LINE 56+50 TO 127+50, SCHUH LATERAL, & BEAR LATERAL
18 - ASPEN, BEAR, FLORIDA LINE 127+50 TO 150+57 & LINE 7 2+00 TO 50+50
19 - LINE 7 50+50 TO 118+50, RESERVE LATERAL, LEFT HAND LATERAL 0+00 TO 3+50, & BIG SANDY LATERAL 0+00 TO 4+50
20 - LINE 7 118+50 TO 186+25 & LEFT HAND LATERAL 3+50 TO 31+50
02-09-21 21 - LEFT HAND LATERAL 31+50 TO 105+88
22 - BIG SANDY LATERAL 4+50 TO 89+14 & RESERVE NORTH LATERAL 0+00 TO 7+77
23 - SPINE A NORTH 0+00 TO 111+50
24 - SPINE A NORTH 111+50 TO 135+61 & FRASER LATERAL 0+00 TO 72+50
02-08-21 25 - FRASER LATERAL 72+50 TO 105+06
26 - CITY OF AURORA FUTURE ROW CROSS SECTIONS
27 - RUSH NORTH LATERAL 4+50 TO 15+18
5-04-21 28 - SPINE G WATERLINE & MUSTANG STATION LATERALS
29 - GRANDE NORTH LATERAL 1+50 TO 6+81
08-10-21

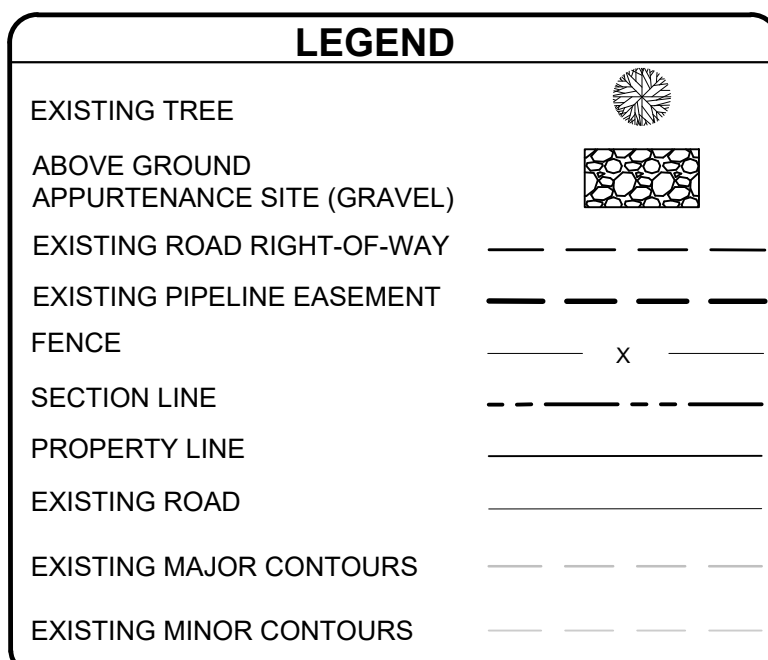

CITY ATTORNEY: _____ DATE: _____

PLANNING DIRECTOR: _____ DATE: _____

PLANNING COMMISSIONER: _____ DATE: _____

CITY COUNCIL: _____ DATE: _____



ATTEST: _____ (CITY CLERK) DATE: _____

DATABASE APPROVAL DATE: _____

RECORDER'S CERTIFICATE:
ACCEPTED FOR FILING IN THE OFFICE OF THE CLERK AND RECORDER OF
COLORADO AT _____ O'CLOCK _____ M, THIS _____ DAY OF _____ AD, _____
CLERK AND RECORDER _____ DEPUTY: _____


- 1: 02/08/2021 - RUSH NORTH LATERAL (1,500 FEET)
- 2: 02/09/2021 - RESERVE NORTH LATERAL (800 FEET)
- 3: 05/04/2021 - SPINE G WATERLINE (6,930 FEET) & MUSTANG STATION LATERALS (2,250 FEET)
- 4: 08/10/2021 - GRANDE NORTH LATERAL (685 FEET)



Cover Sheet - Amendment #4.dwg

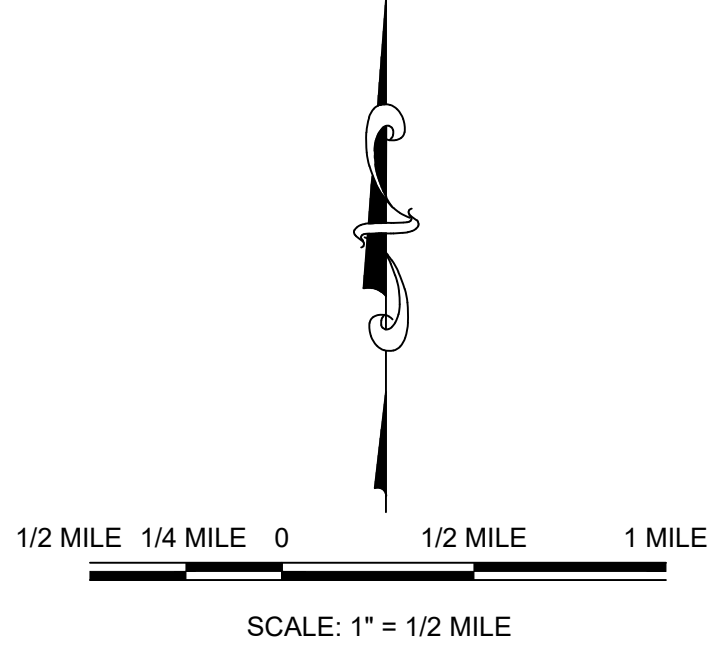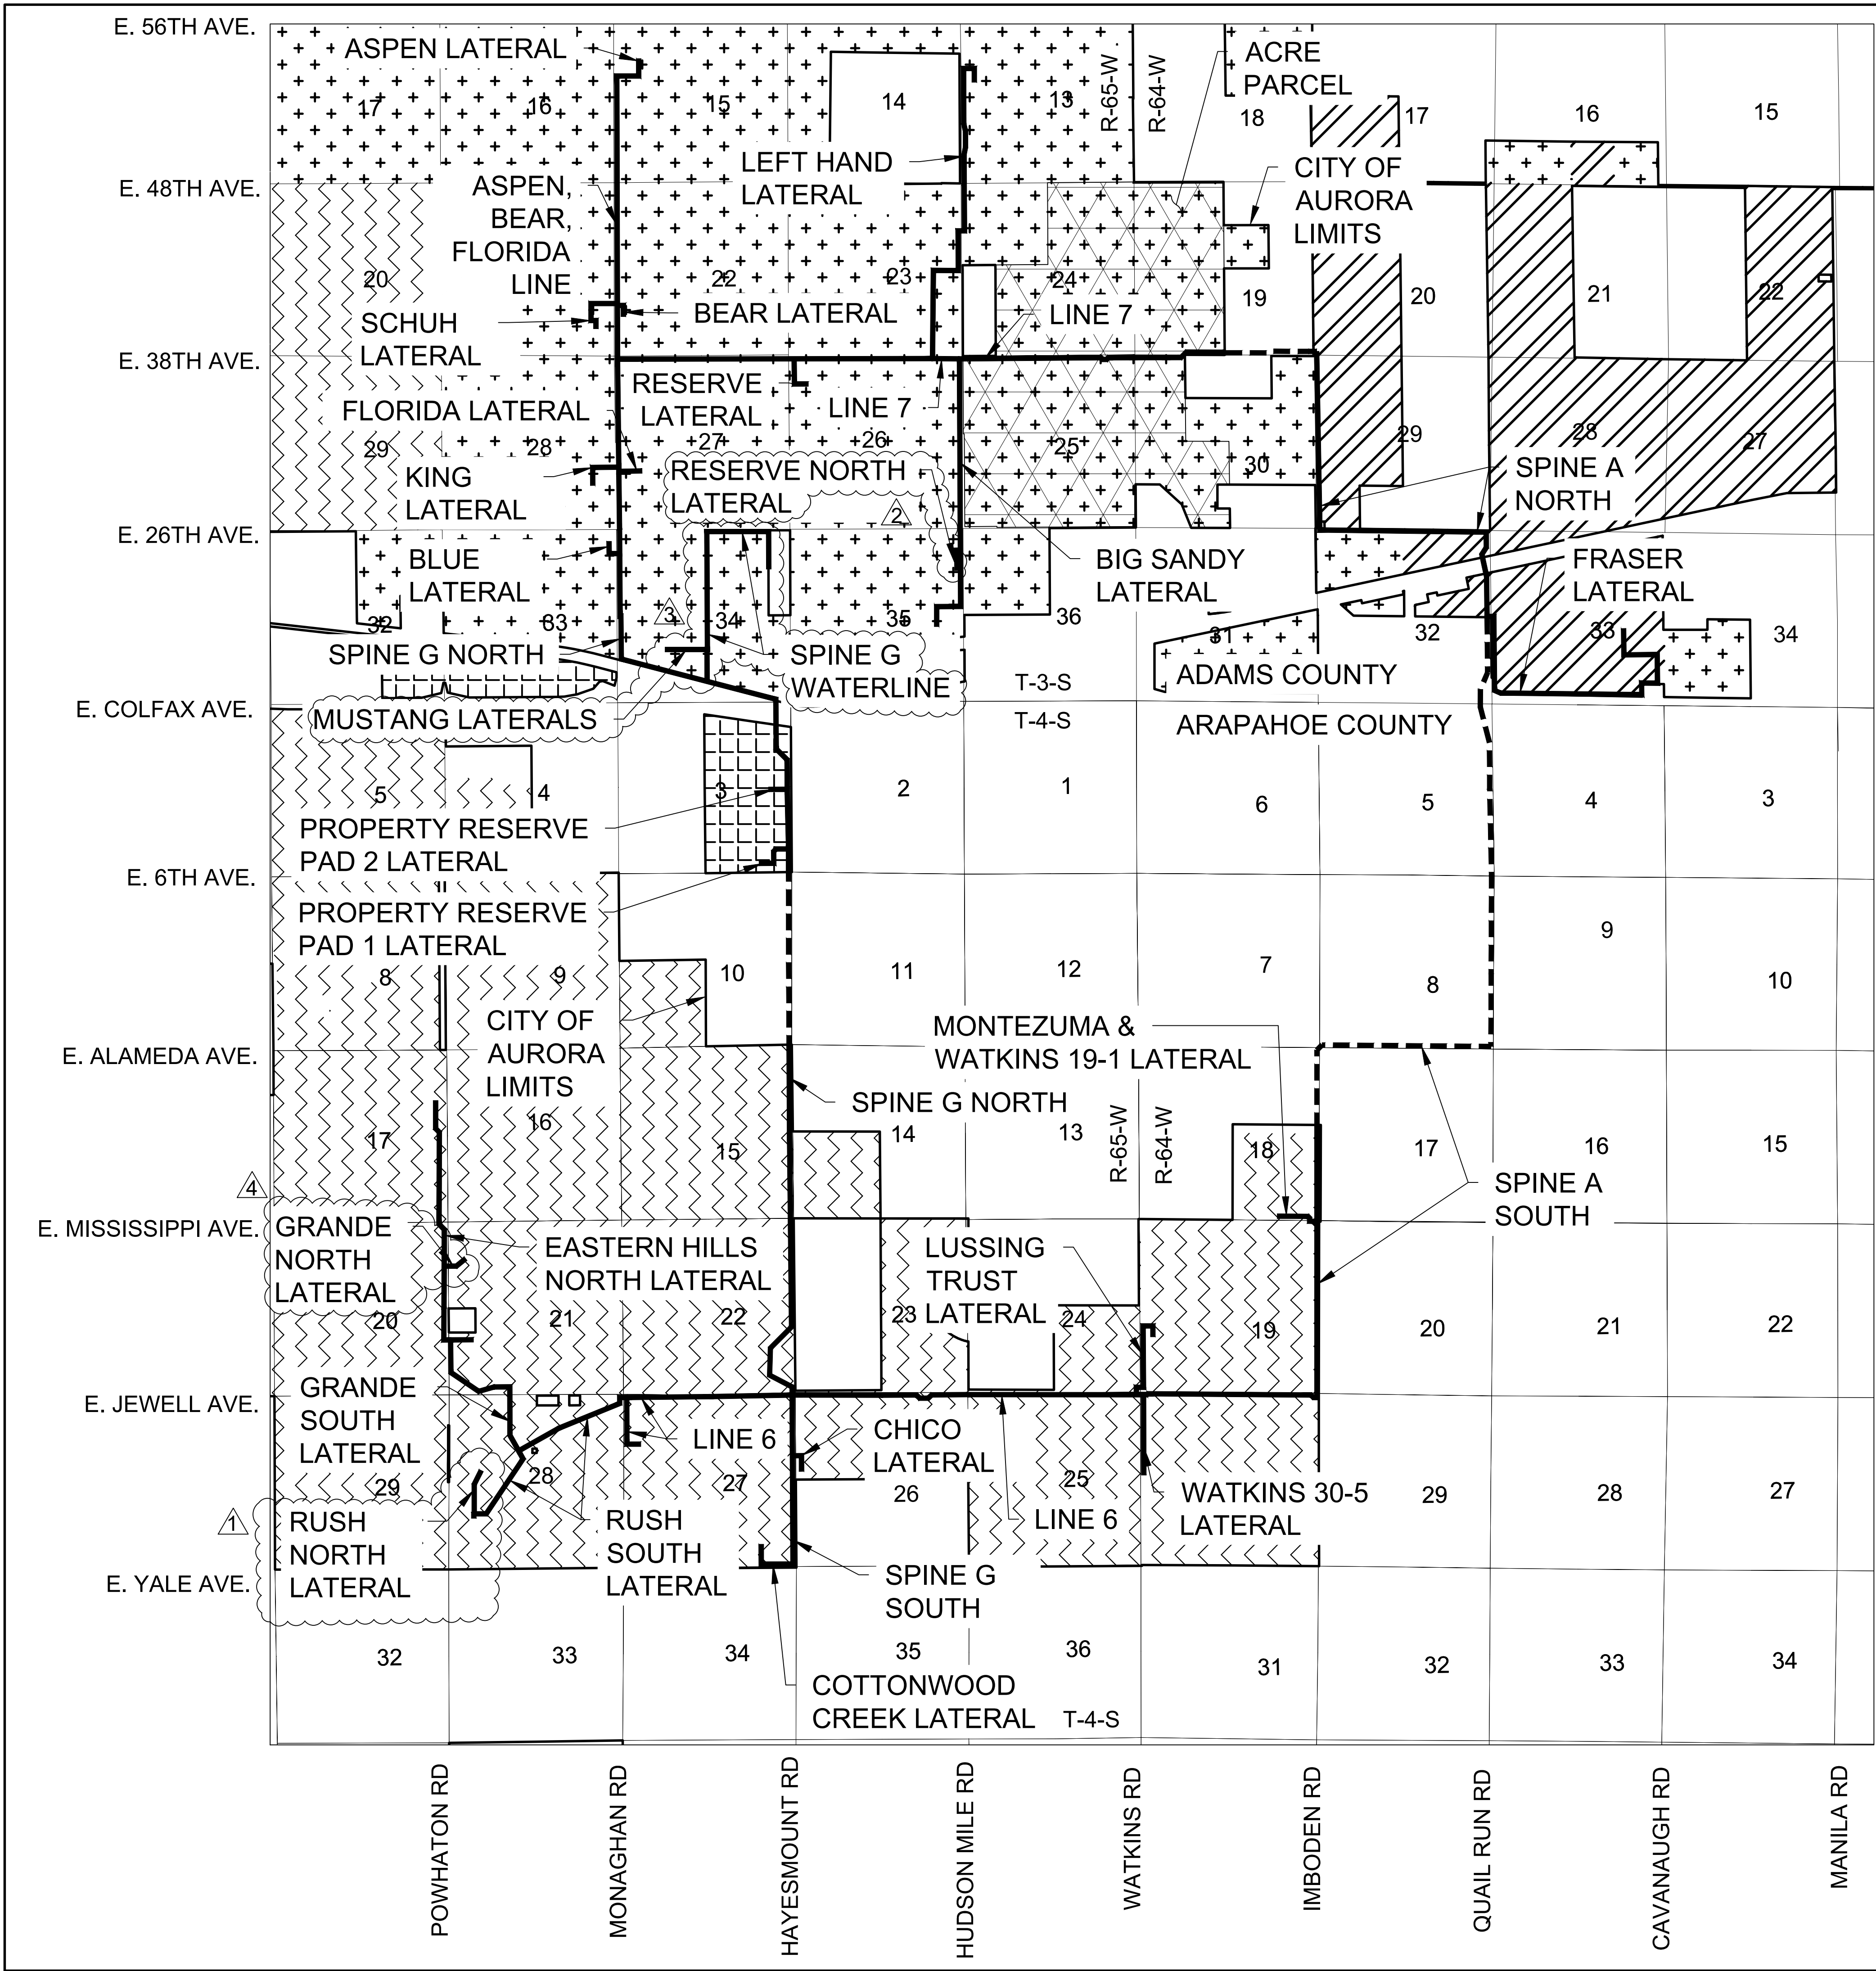

- LEGEND**
- PIPELINE WITHIN CITY OF AURORA LIMITS
 - PIPELINE OUTSIDE CITY OF AURORA LIMITS
 - MU-A - MIXED USE AIRPORT
 - AD - AIRPORT DISTRICT
 - I-2 - INDUSTRIAL DISTRICT
 - R-2 - MEDIUM-DENSITY RESIDENTIAL DISTRICT

 
- NOTES**
- ALL AMENDMENTS TO THIS SITE PLAN SHALL UTILIZE EASEMENTS THAT DO NOT SIGNIFICANTLY ENCUMBER CURBSIDE LANDSCAPING OR STREET FRONTAGE LANDSCAPE BUFFERS FOR FUTURE DEVELOPMENTS. THIS CAN BE DONE BY EITHER LOCATING ALL EASEMENTS OUTSIDE OF THESE IDENTIFIED AREAS OR INCLUDING EASEMENT LANGUAGE THAT ALLOWS SUFFICIENT PLANTINGS (AS DETERMINED BY THE CITY LANDSCAPE ARCHITECT) TO BE INSTALLED WITHIN EASEMENTS.
 - THE GATHERING SYSTEM AND FLOWLINE WILL NOT HAVE ANY UNDUE ADVERSE EFFECTS ON EXISTING AND FUTURE DEVELOPMENT OF THE SURROUNDING AREA AS SET FORTH IN APPLICABLE CITY MASTER PLANS. THE DESIGN OF THE PROPOSED GATHERING SYSTEM AND FLOWLINE MITIGATES NEGATIVE IMPACTS ON THE SURROUND AREA TO THE GREATEST EXTENT FEASIBLE. THE DISTURBED AREA SHALL BE MAINTAINED DURING CONSTRUCTION BY THE APPLICANT OR PROPERTY OWNER IN SUCH A MANNER TO CONTROL SOIL EROSION, DUST AND THE GROWTH OF NOXIOUS WEEDS.



SHEET NUMBER <div>2</div>	DRAWN BY:	KRW	SCALE:	NATURAL GAS PIPELINE GATHERING SYSTEM AS-BUILT SITE PLAN			CRESTONE PEAK RESOURCES MIDSTREAM LLC ATTN: DAVID STEWART 10188 E. 125 FRONTAGE ROAD FIRESTONE CO 80504 PHONE: (303) 774-3909			<div> CML CONSULTANTS CIVIL ENGINEERING LAND SURVEYING</div>	10333 E. Dry Creek Rd. Suite 240 Englewood, CO 80112 Tel: (720) 482-9566 Fax: (720) 482-9546			4 GRANDE NORTH LATERAL			08-10-21			KRW	
	CHECKED BY:	MEL	AS SHOWN								3 SPINE G WATERLINE & MUSTANG STATION LATERALS			05-04-21			KRW				
	DATE:	08/19/2020	FILE NO:	8.13.0330001	CITY OF AURORA LIMITS & ZONING						2 RESERVE NORTH LATERAL			02-09-21			KRW				
											1 RUSH NORTH LATERAL			02-08-21			KRW				
											No.	Revisions		Date	Appr.	Date					

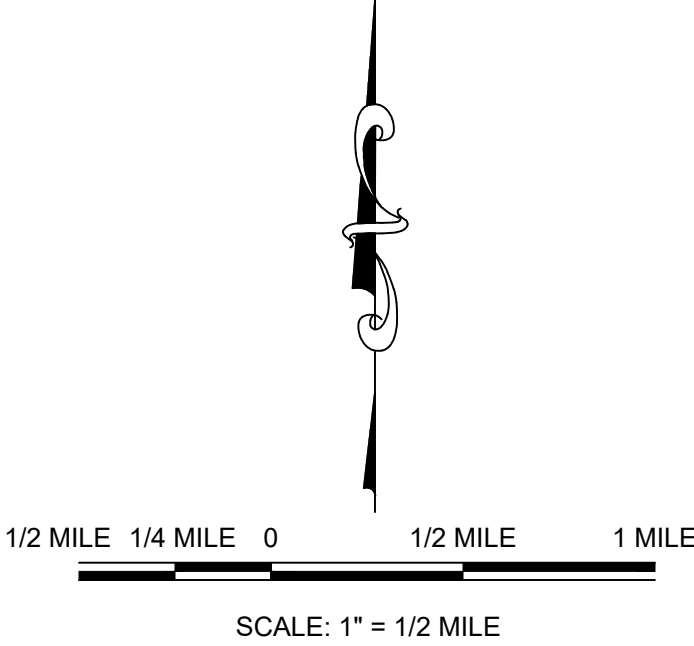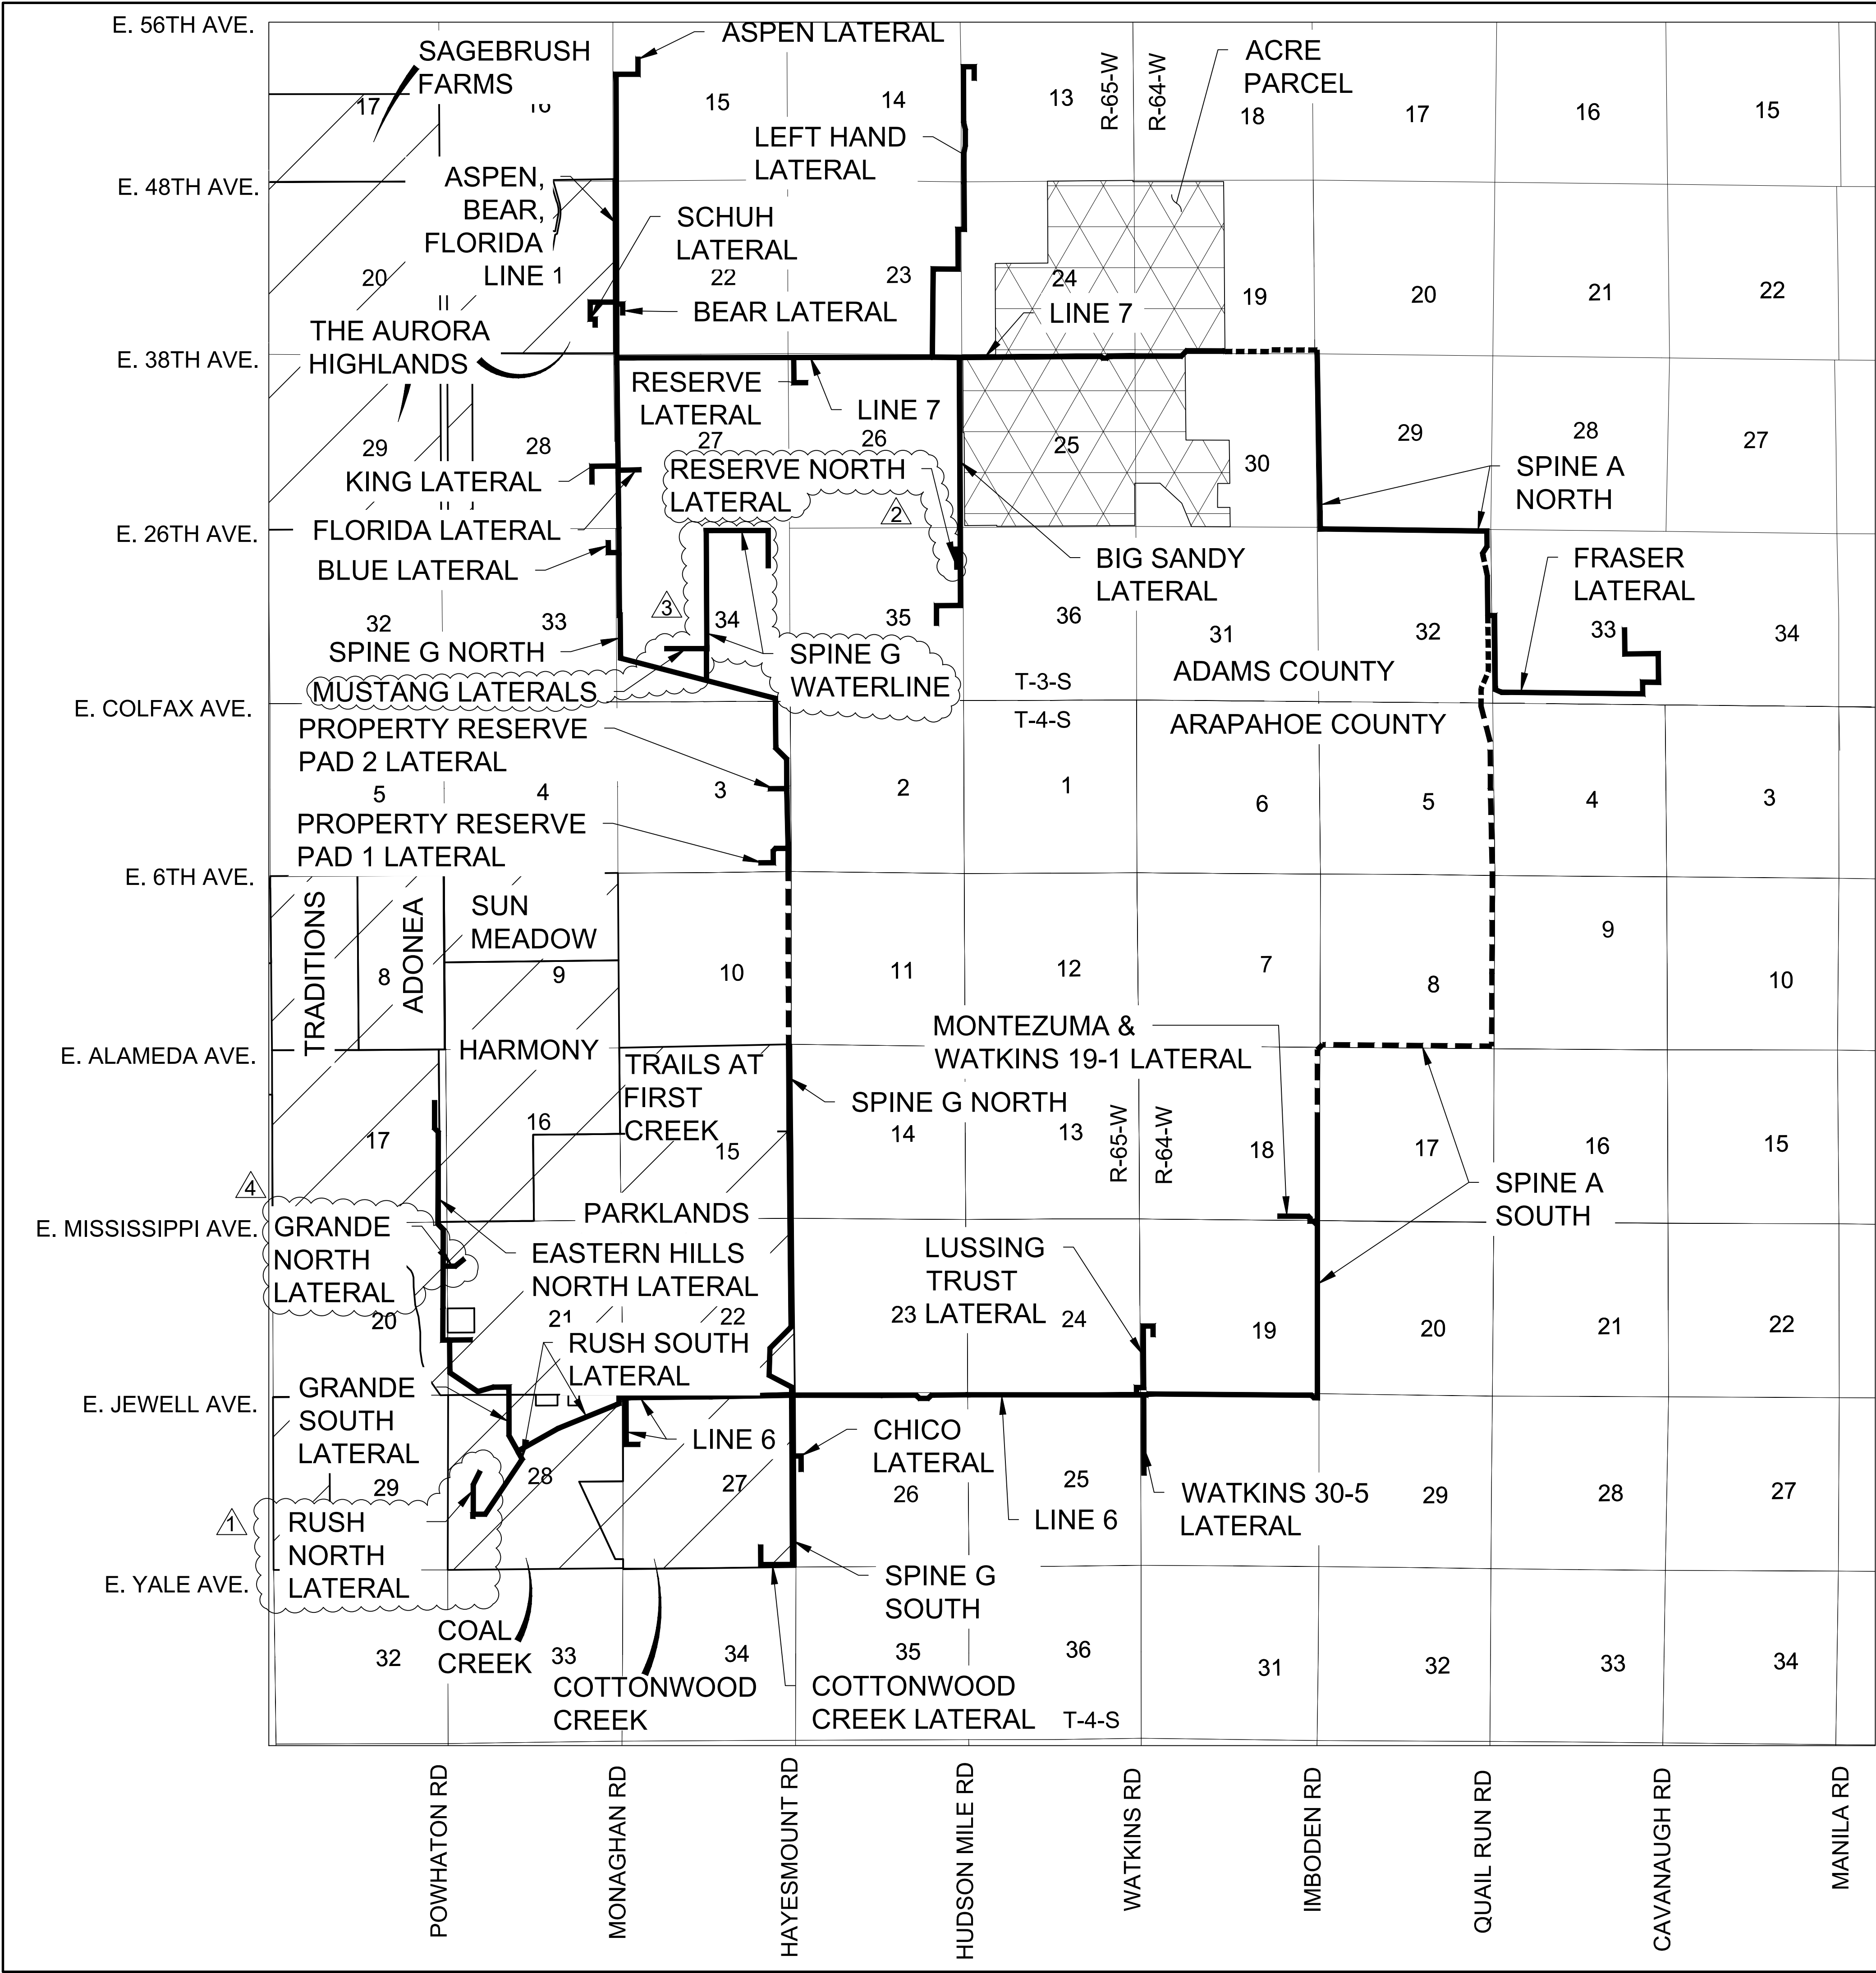

- LEGEND**
- PIPELINE WITHIN CITY OF AURORA LIMITS
 - PIPELINE OUTSIDE CITY OF AURORA LIMITS
 - EXISTING NEIGHBORHOOD

- NOTES**
- ALL AMENDMENTS TO THIS SITE PLAN SHALL UTILIZE EASEMENTS THAT DO NOT SIGNIFICANTLY ENCUMBER CURBSIDE LANDSCAPING OR STREET FRONTAGE LANDSCAPE BUFFERS FOR FUTURE DEVELOPMENTS. THIS CAN BE DONE BY EITHER LOCATING ALL EASEMENTS OUTSIDE OF THESE IDENTIFIED AREAS OR INCLUDING EASEMENT LANGUAGE THAT ALLOWS SUFFICIENT PLANTINGS (AS DETERMINED BY THE CITY LANDSCAPE ARCHITECT) TO BE INSTALLED WITHIN EASEMENTS.
 - THE GATHERING SYSTEM AND FLOWLINE WILL NOT HAVE ANY UNDUE ADVERSE EFFECTS ON EXISTING AND FUTURE DEVELOPMENT OF THE SURROUNDING AREA AS SET FORTH IN APPLICABLE CITY MASTER PLANS. THE DESIGN OF THE PROPOSED GATHERING SYSTEM AND FLOWLINE MITIGATES NEGATIVE IMPACTS ON THE SURROUND AREA TO THE GREATEST EXTENT FEASIBLE. THE DISTURBED AREA SHALL BE MAINTAINED DURING CONSTRUCTION BY THE APPLICANT OR PROPERTY OWNER IN SUCH A MANNER TO CONTROL SOIL EROSION, DUST AND THE GROWTH OF NOXIOUS WEEDS.

SHEET NUMBER 3	DRAWN BY: KRW	CHECKED BY: MEL	DATE: 08/19/2020	SCALE: AS SHOWN FILE NO: 8.13.0330001	NATURAL GAS PIPELINE GATHERING SYSTEM AS-BUILT SITE PLAN CRESTONE PEAK RESOURCES MIDSTREAM LLC CITY OF AURORA NEIGHBORHOOD MAP	CRESTONE PEAK RESOURCES MIDSTREAM LLC ATTN: DAVID STEWART 10188 E. 1-26 FRONTAGE ROAD FIRESTONE CO 80504 PHONE (303) 774-3909	 CONSULTANTS CIVIL ENGINEERING LAND SURVEYING	10333 E. Dry Creek Rd. Suite 240 Englewood, CO 80112 Tel: (720) 482-9526 Fax: (720) 482-9546	Revisions			No.			Date	Appr.	Date	
									4									
3										SPINE G WATERLINE & MUSTANG STATION LATERALS			02-09-21			KRW		
2										RESERVE NORTH LATERAL			02-08-21			KRW		
1										RUSH NORTH LATERAL			02-08-21			KRW		

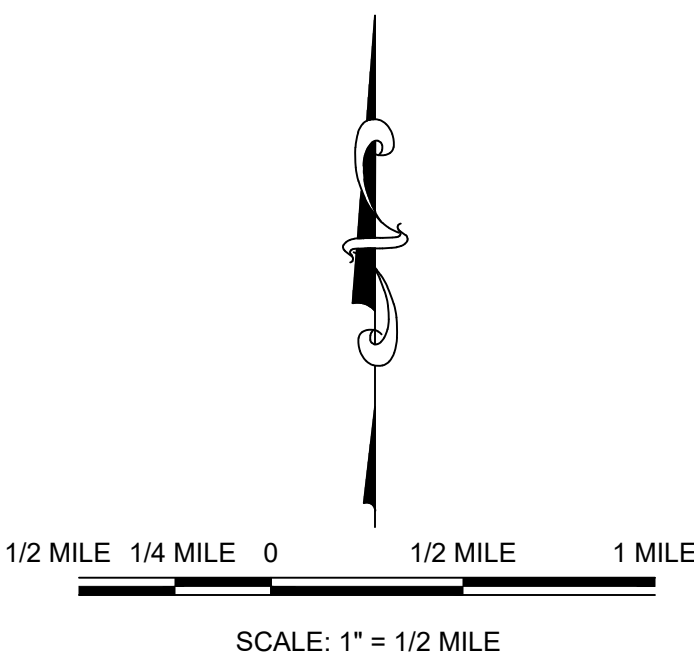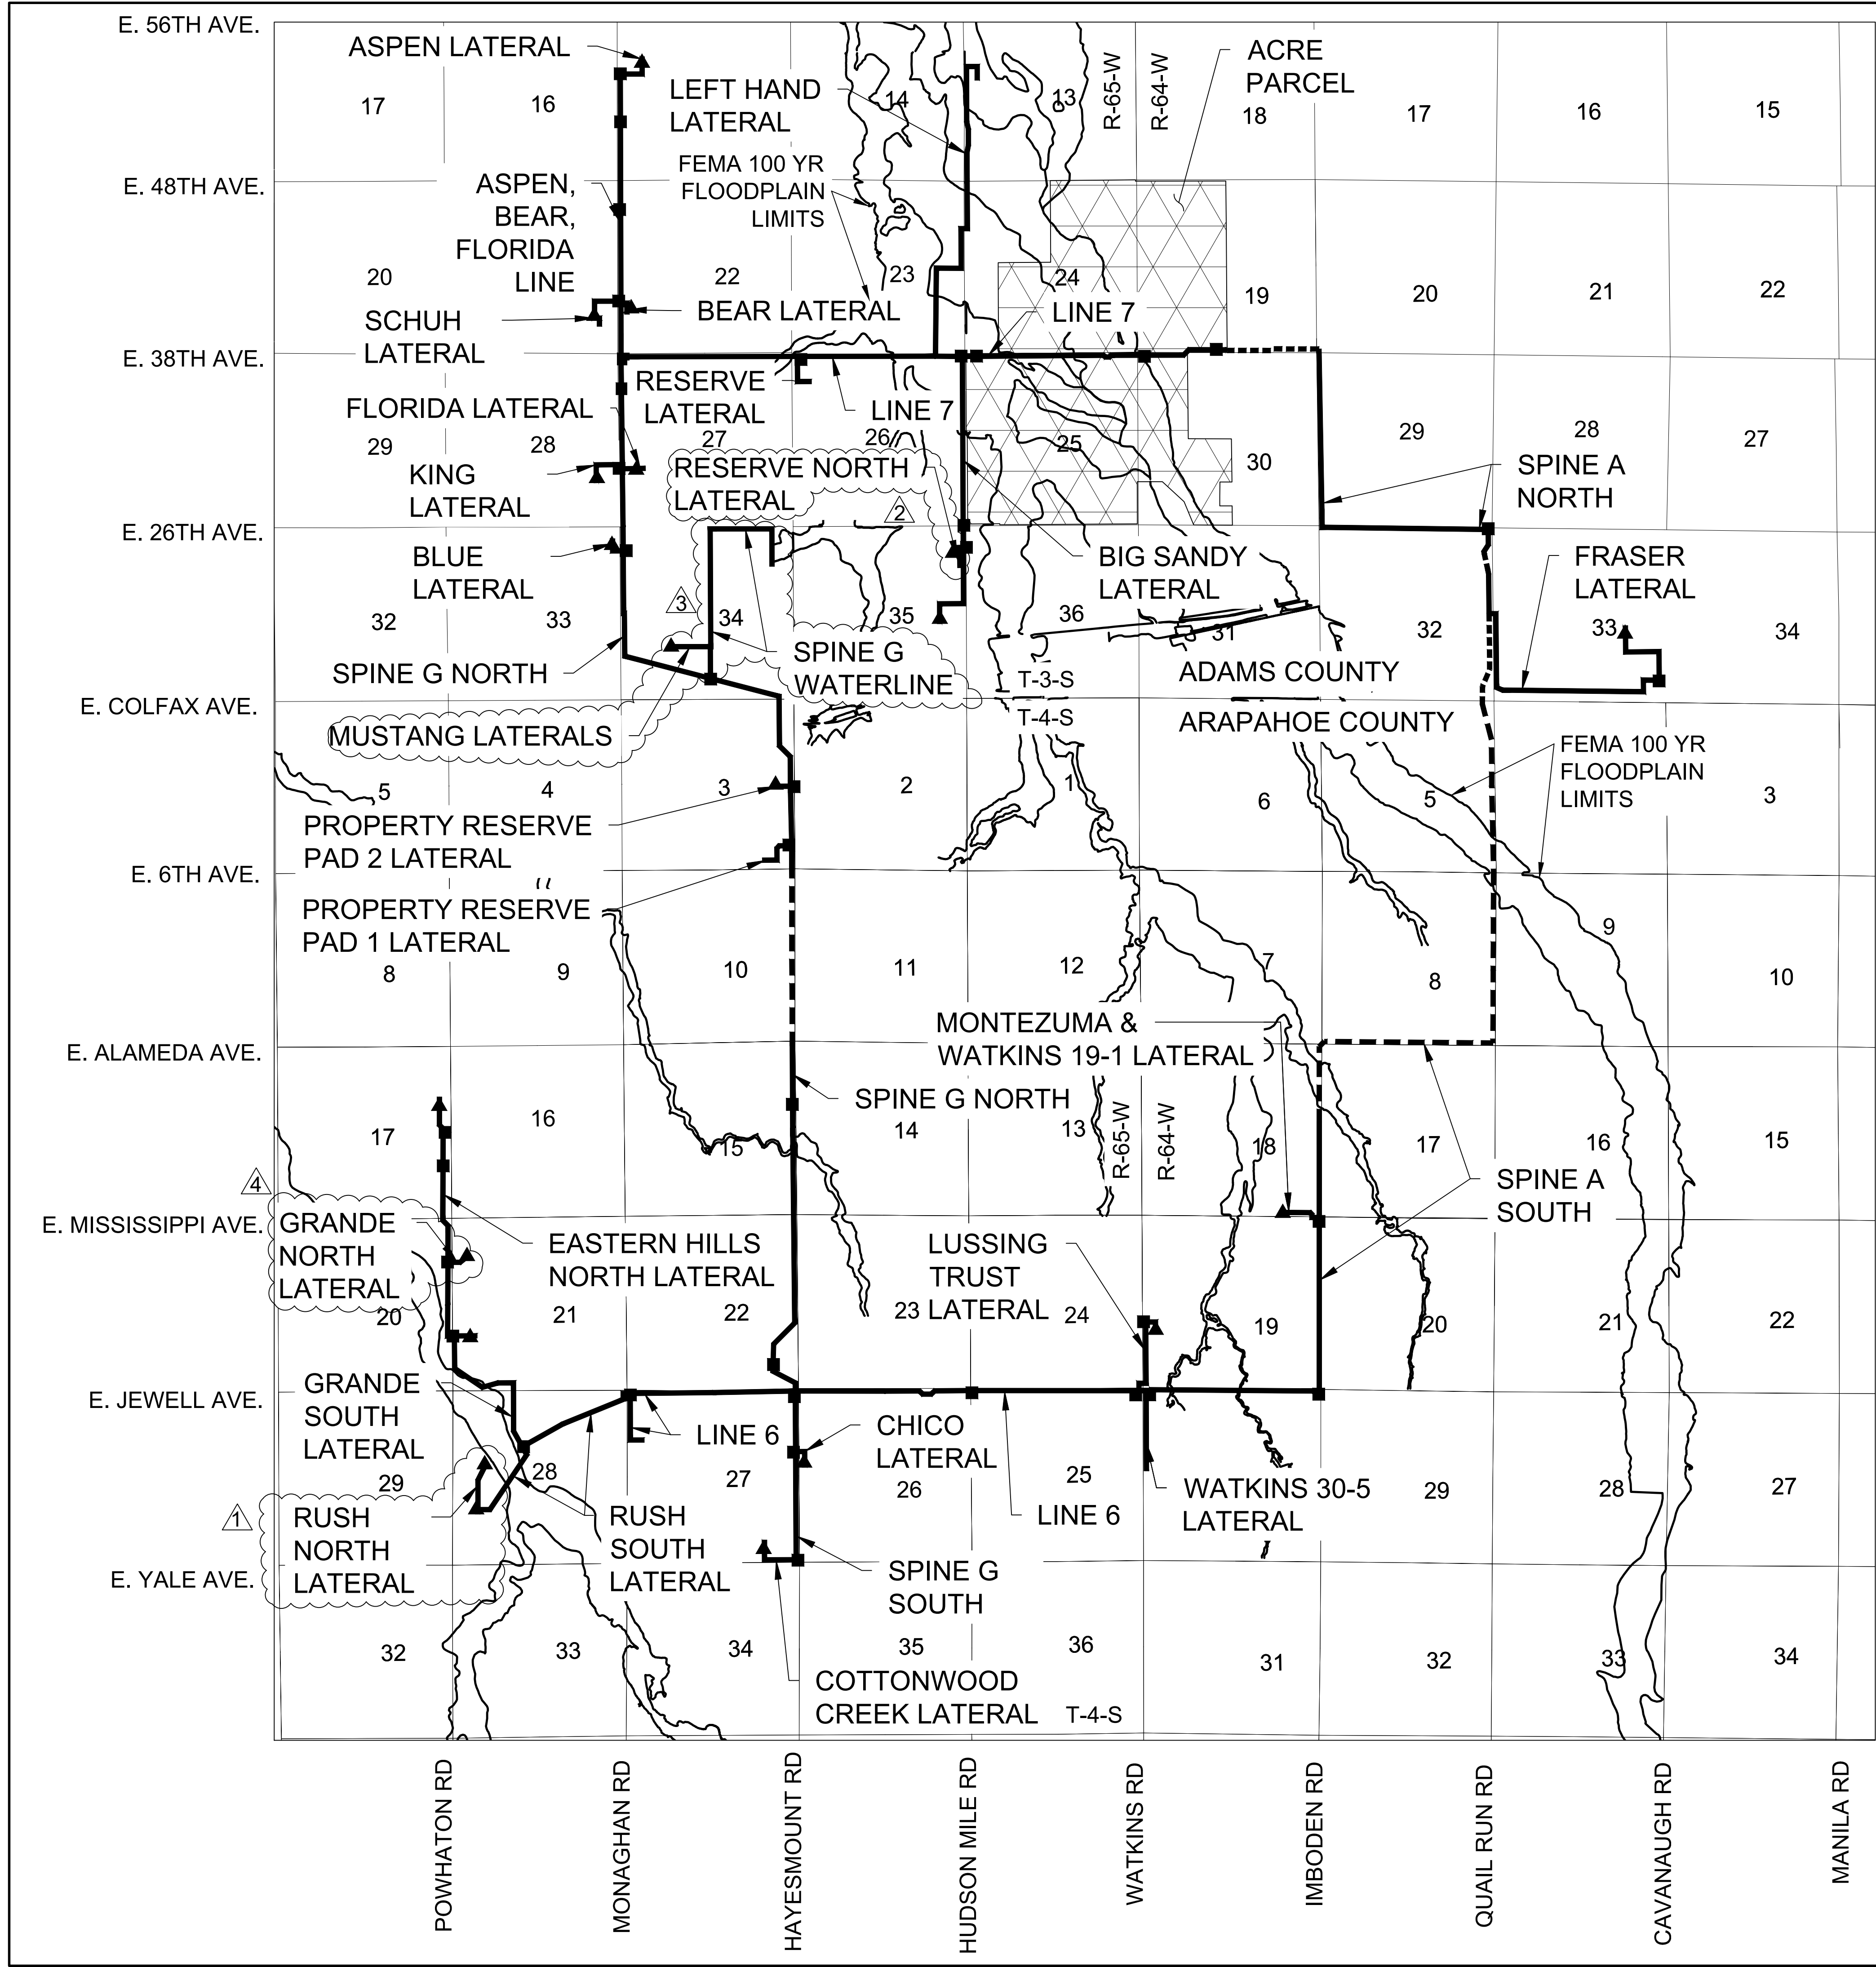



- LEGEND**
- PIPELINE WITHIN CITY OF AURORA LIMITS
 - PIPELINE OUTSIDE CITY OF AURORA LIMITS
 - ABOVE GROUND APPURTENANCE SITE LOCATIONS WITHIN CITY OF AURORA
 - WELL PAD APPURTENANCE SITE LOCATIONS WITHIN CITY OF AURORA








ABOVE GROUND APPURTENANCE EQUIPMENT EXAMPLE



- NOTES**
- ALL AMENDMENTS TO THIS SITE PLAN SHALL UTILIZE EASEMENTS THAT DO NOT SIGNIFICANTLY ENCUMBER CURBSIDE LANDSCAPING OR STREET FRONTAGE LANDSCAPE BUFFERS FOR FUTURE DEVELOPMENTS. THIS CAN BE DONE BY EITHER LOCATING ALL EASEMENTS OUTSIDE OF THESE IDENTIFIED AREAS OR INCLUDING EASEMENT LANGUAGE THAT ALLOWS SUFFICIENT PLANTINGS (AS DETERMINED BY THE CITY LANDSCAPE ARCHITECT) TO BE INSTALLED WITHIN EASEMENTS.
 - THE GATHERING SYSTEM AND FLOWLINE WILL NOT HAVE ANY UNDUE ADVERSE EFFECTS ON EXISTING AND FUTURE DEVELOPMENT OF THE SURROUNDING AREA AS SET FORTH IN APPLICABLE CITY MASTER PLANS. THE DESIGN OF THE PROPOSED GATHERING SYSTEM AND FLOWLINE MITIGATES NEGATIVE IMPACTS ON THE SURROUND AREA TO THE GREATEST EXTENT FEASIBLE. THE DISTURBED AREA SHALL BE MAINTAINED DURING CONSTRUCTION BY THE APPLICANT OR PROPERTY OWNER IN SUCH A MANNER TO CONTROL SOIL EROSION, DUST AND THE GROWTH OF NOXIOUS WEEDS.

SHEET NUMBER	4		DRAWN BY: KRW	CHECKED BY: MEL	DATE: 08/19/2020	8.13.0330001	NATURAL GAS PIPELINE GATHERING SYSTEM AS-BUILT SITE PLAN CRESTONE PEAK RESOURCES MIDSTREAM LLC APURTENANCE SITE & FEMA FLOODPLAIN MAP	CRESTONE PEAK RESOURCES MIDSTREAM LLC ATTN: DAVID STEWART 10168 E. 1-25 FRONTAGE ROAD FIRESTONE CO 80504 PHONE: (303) 774-3909			CRESTONE PEAK RESOURCES MIDSTREAM LLC ATTN: DAVID STEWART 10333 E. Dry Creek Rd. Suite 240 Englewood, CO 80112 Tel: (720) 482-9526 Fax: (720) 482-9546	4	SPINE G WATERLINE & MUSTANG STATION LATERALS	05-04-21	KRW	08-10-21	KRW				
	SCALE: AS SHOWN	FILE NO:																1	RUSH NORTH LATERAL	02-08-21	KRW
Revisions												No.	Date	Init.	Appr.	Date					


Flowgram & Apurtenance - Amendment #4.dwg

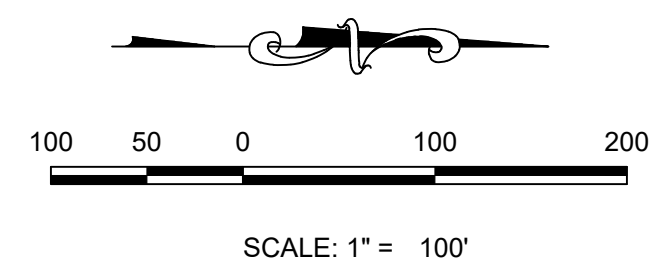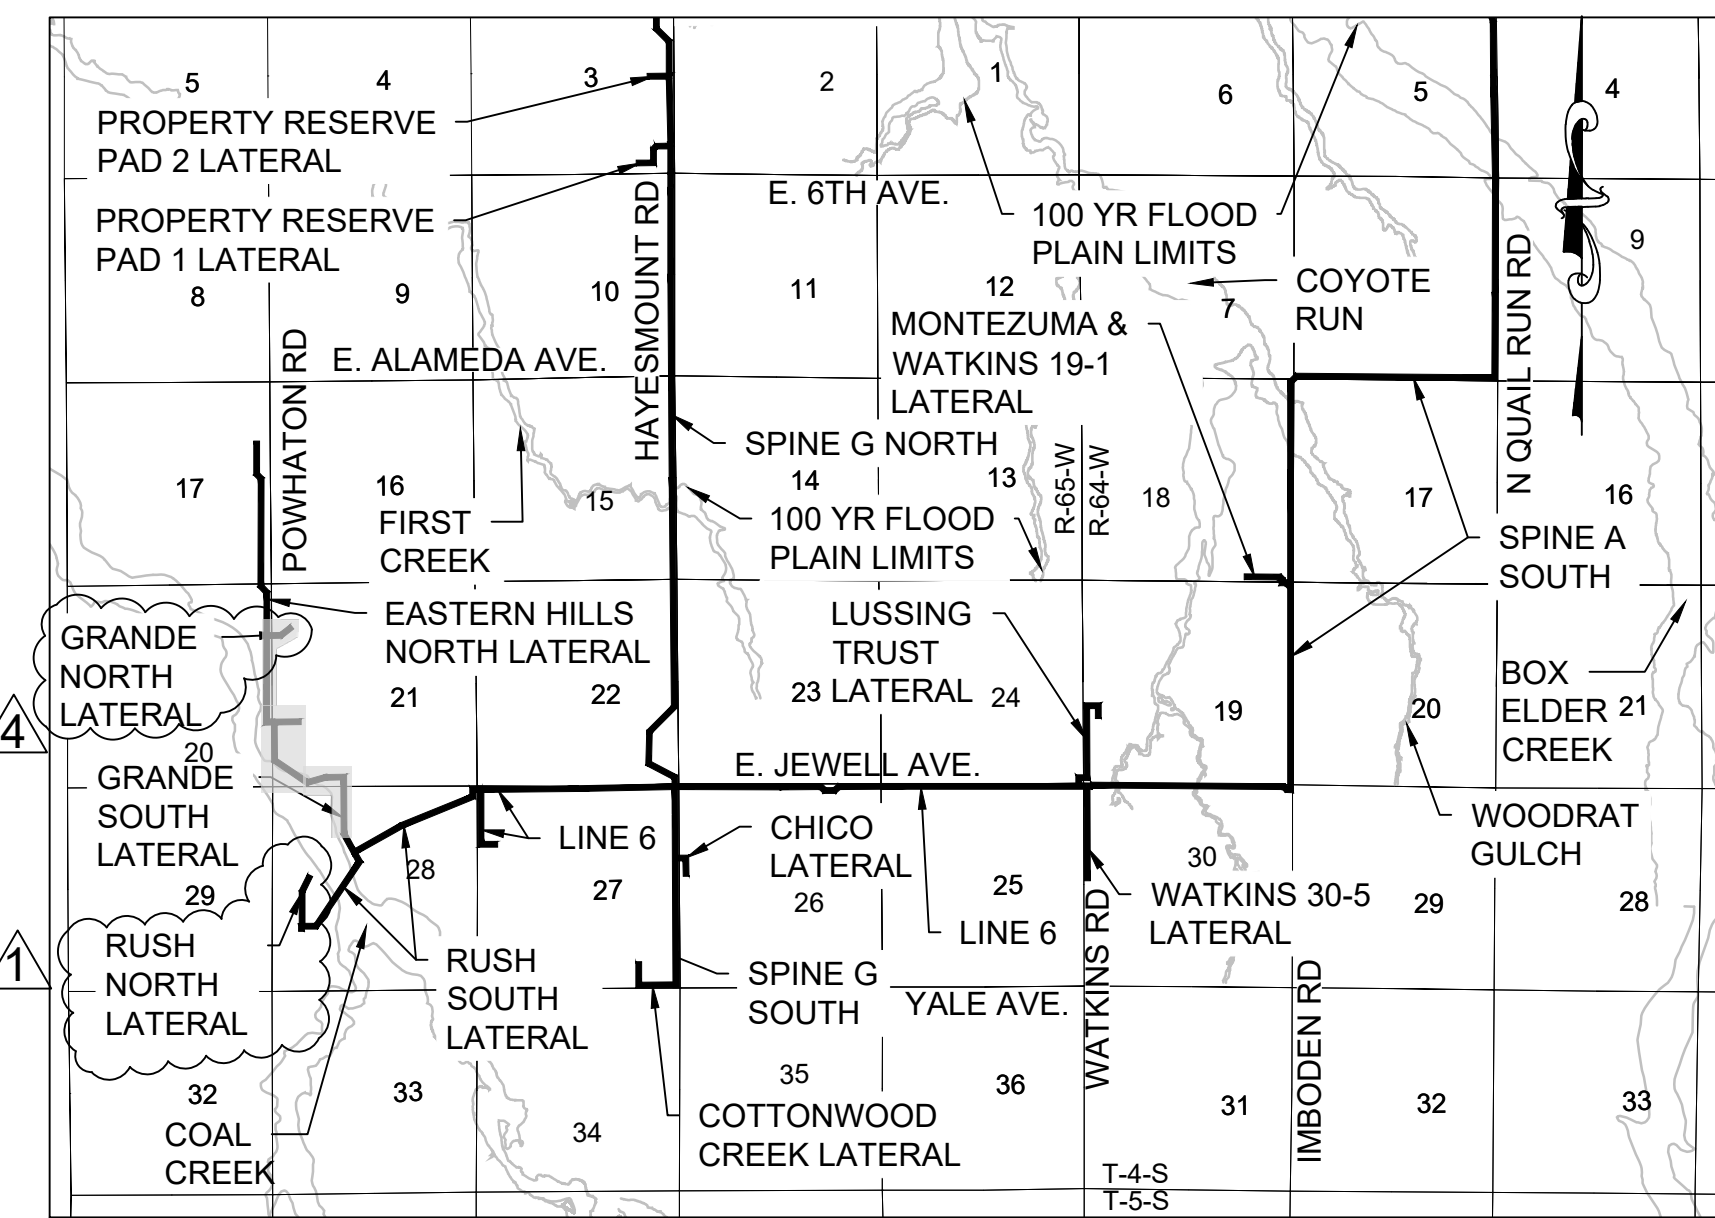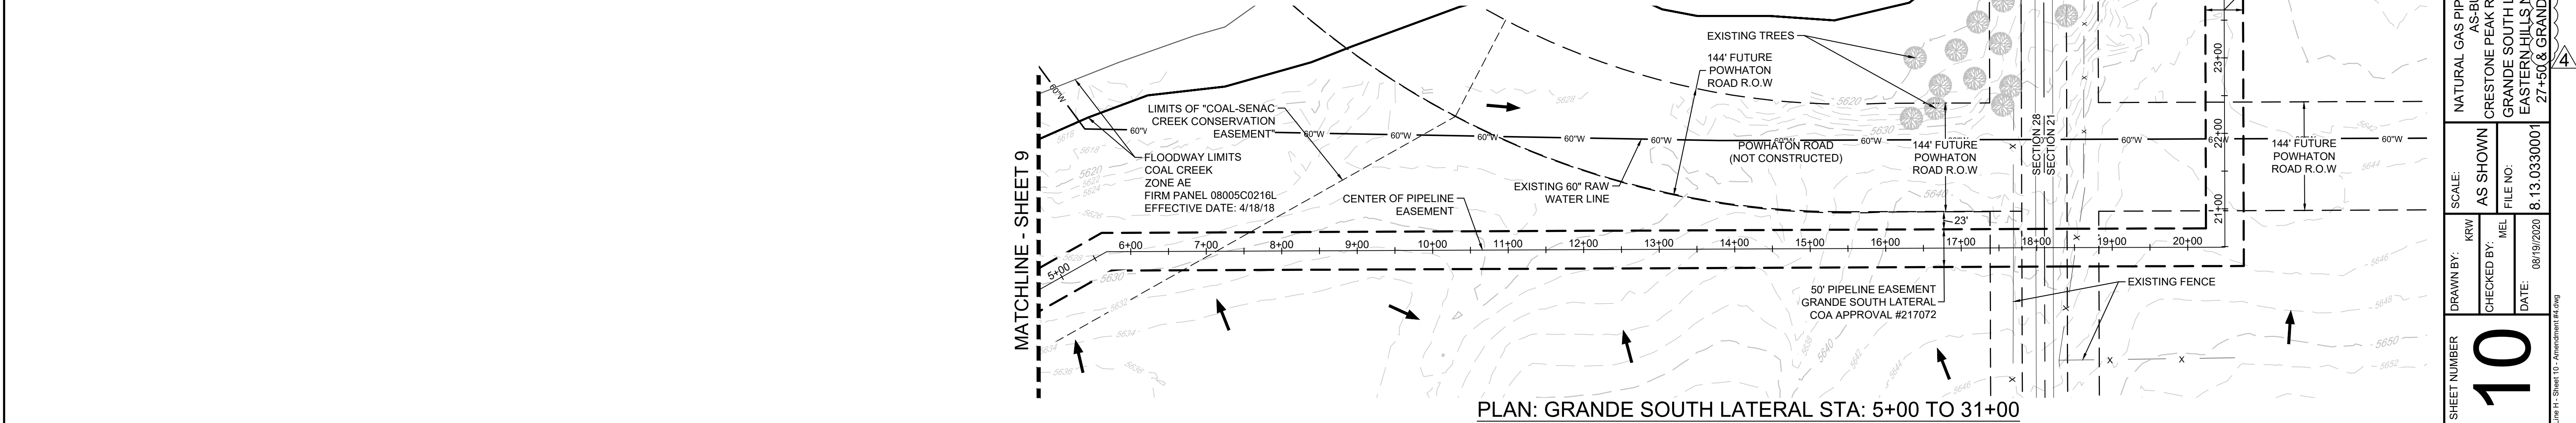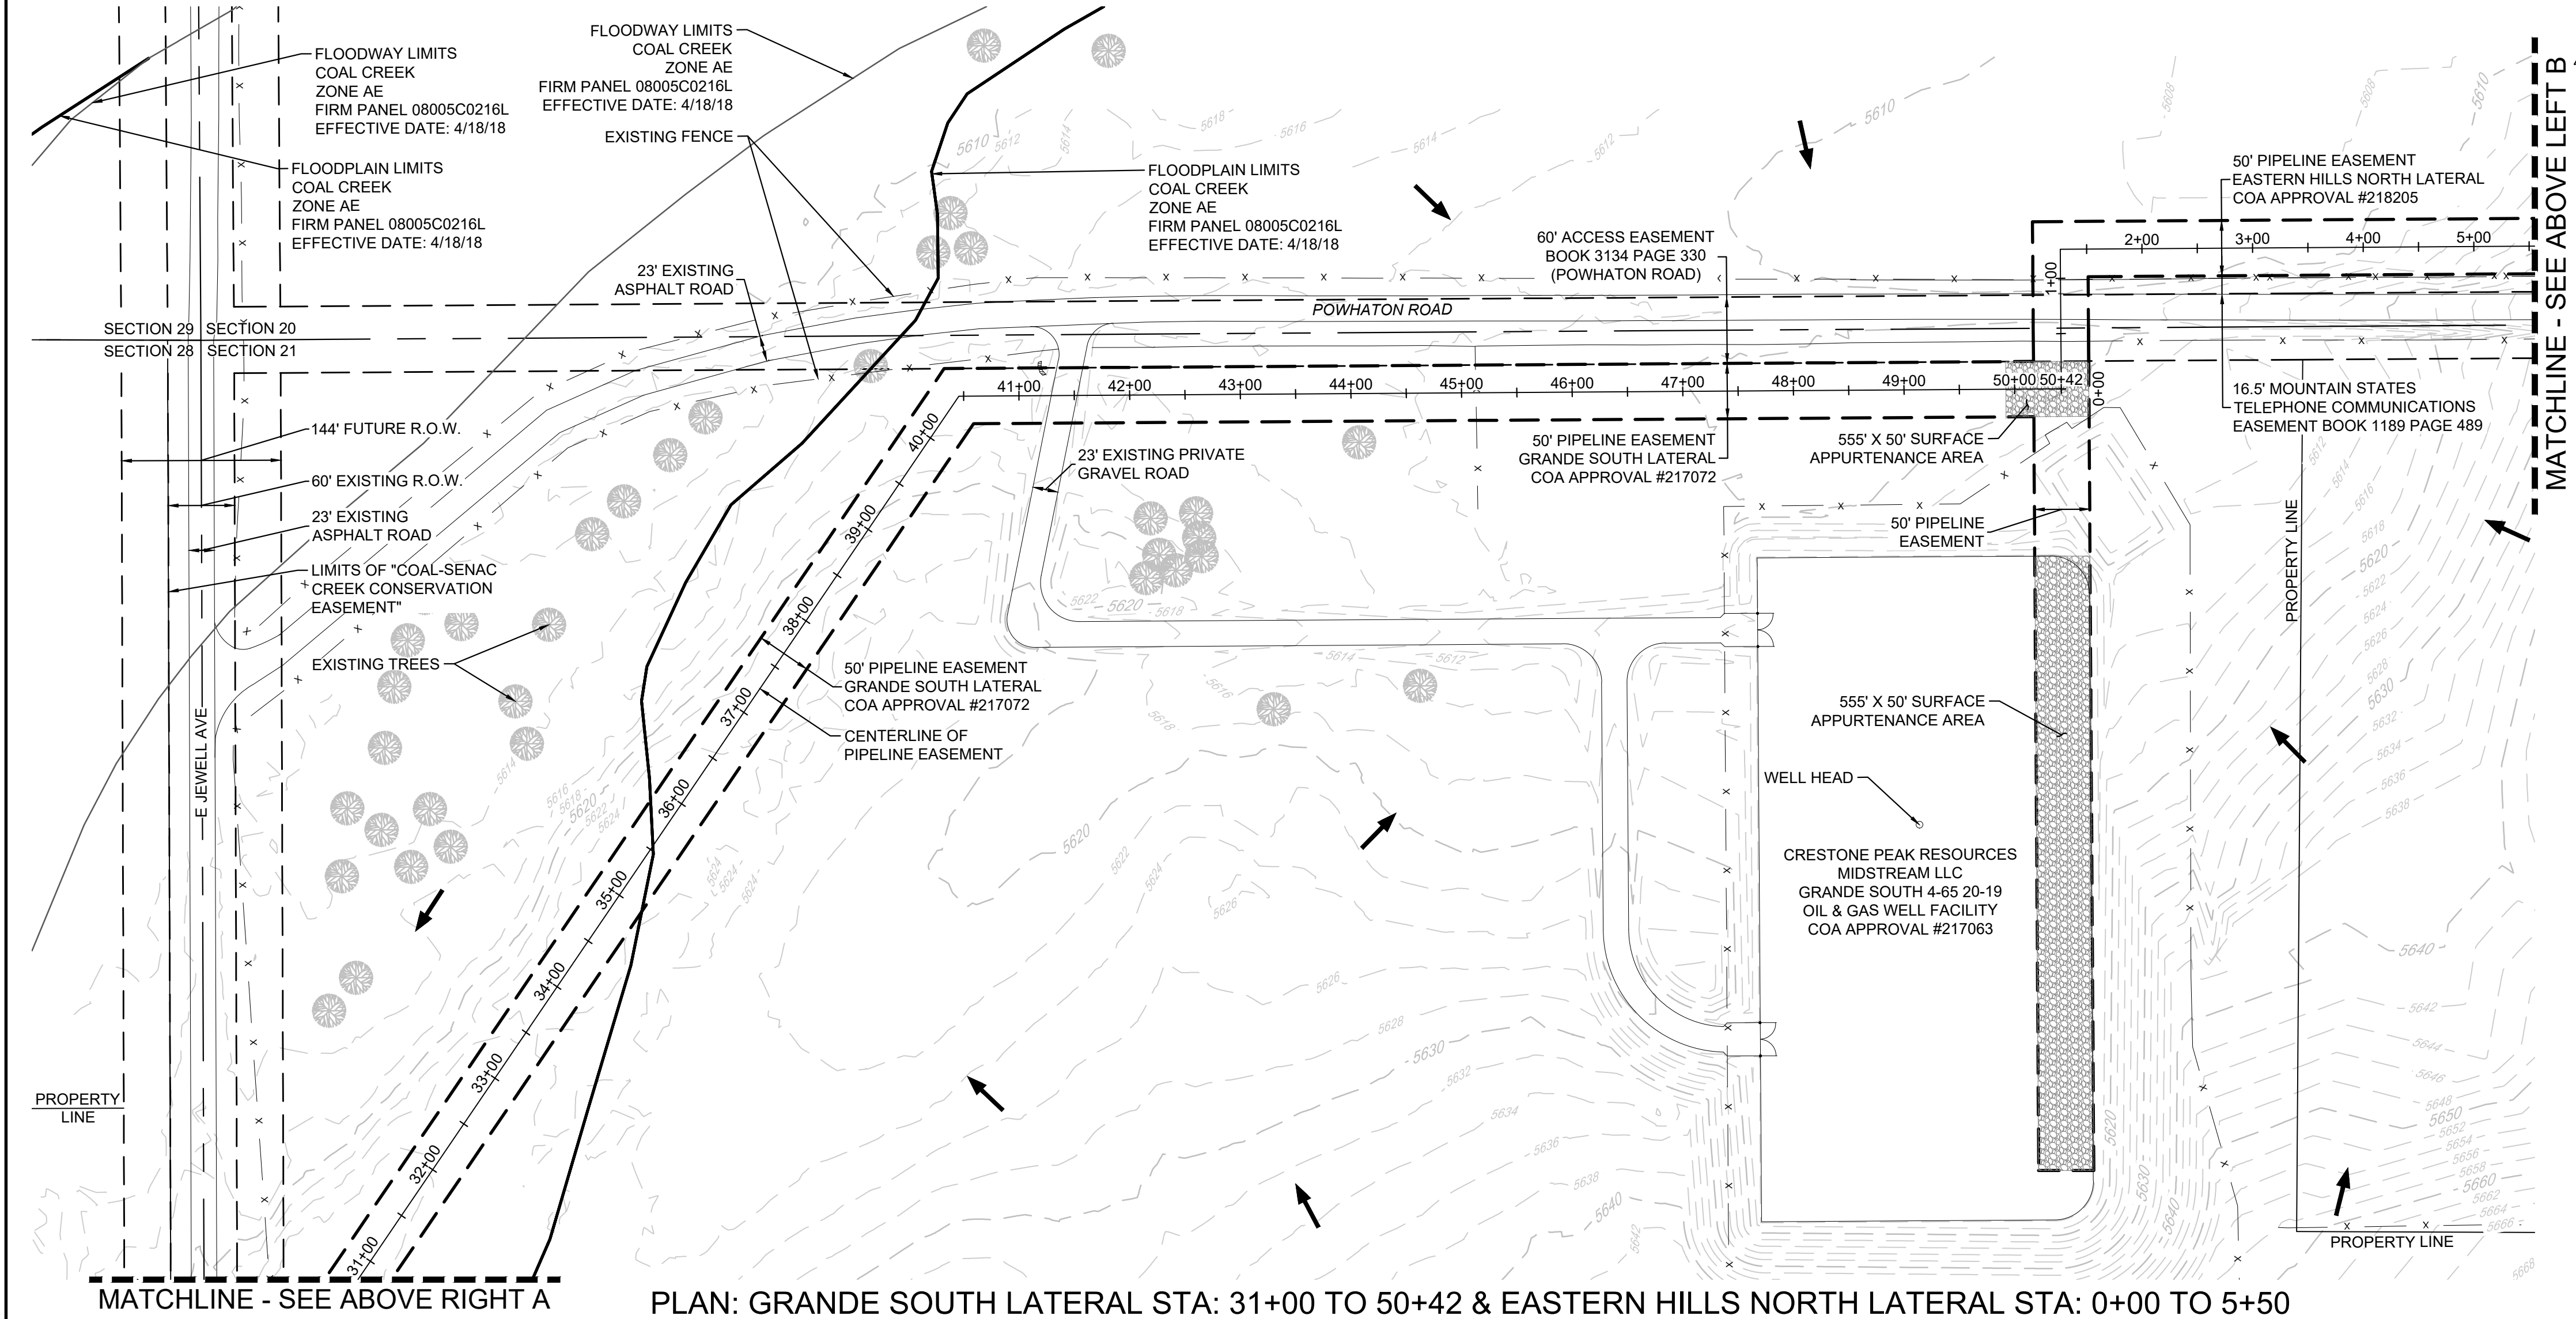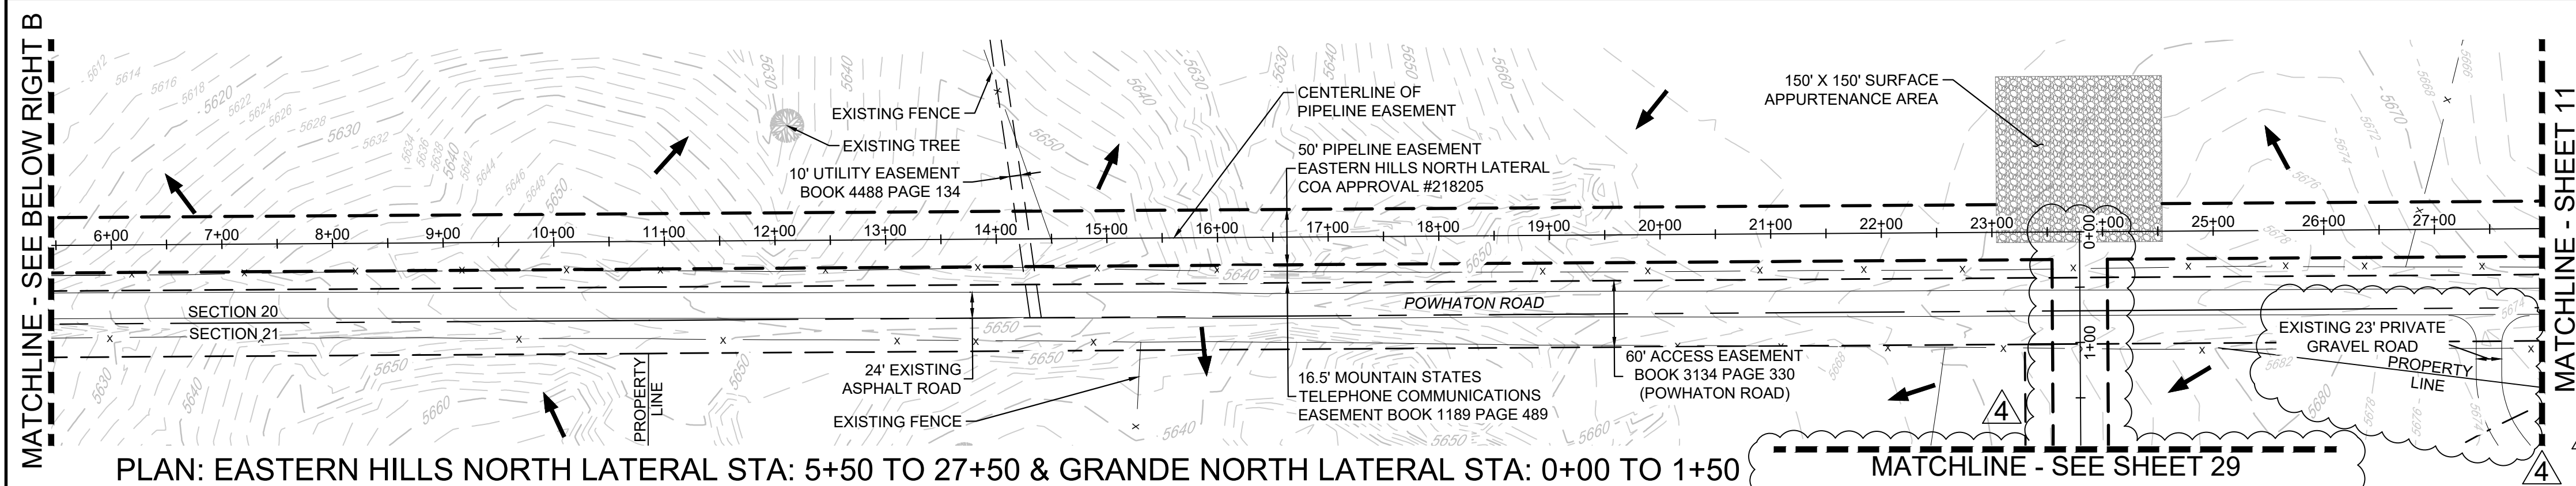

10333 E. Dry Creek Rd. Suite 240 Englewood, CO 80112 Tel: (720) 482-9556 Fax: (720) 482-9556	Revisions		Date	Appr.	Init.
	1		02-08-21	KRW	
	4		08-10-21	KRW	
	GRANDE NORTH LATERAL				
RUSH NORTH LATERAL					
NATURAL GAS PIPELINE GATHERING SYSTEM		AS-BUILT SITE PLAN		CRESTONE PEAK RESOURCES MIDSTREAM LLC	
CRESTONE PEAK RESOURCES MIDSTREAM LLC		ATTN: DAVID STEWART		10188 E. 1-25 FRONTAGE ROAD FIRESTONE CO 80504 PHONE: (303) 774-3909	
SCALE: AS SHOWN		FILE NO: 8.13.0330001		DATE: 08/19/2020	
DRAWN BY: KRW		CHECKED BY: MEL		DATE: 08/19/2020	
SHEET NUMBER		10		Line 11 - Sheet 10 - Amendment #4.dwg	

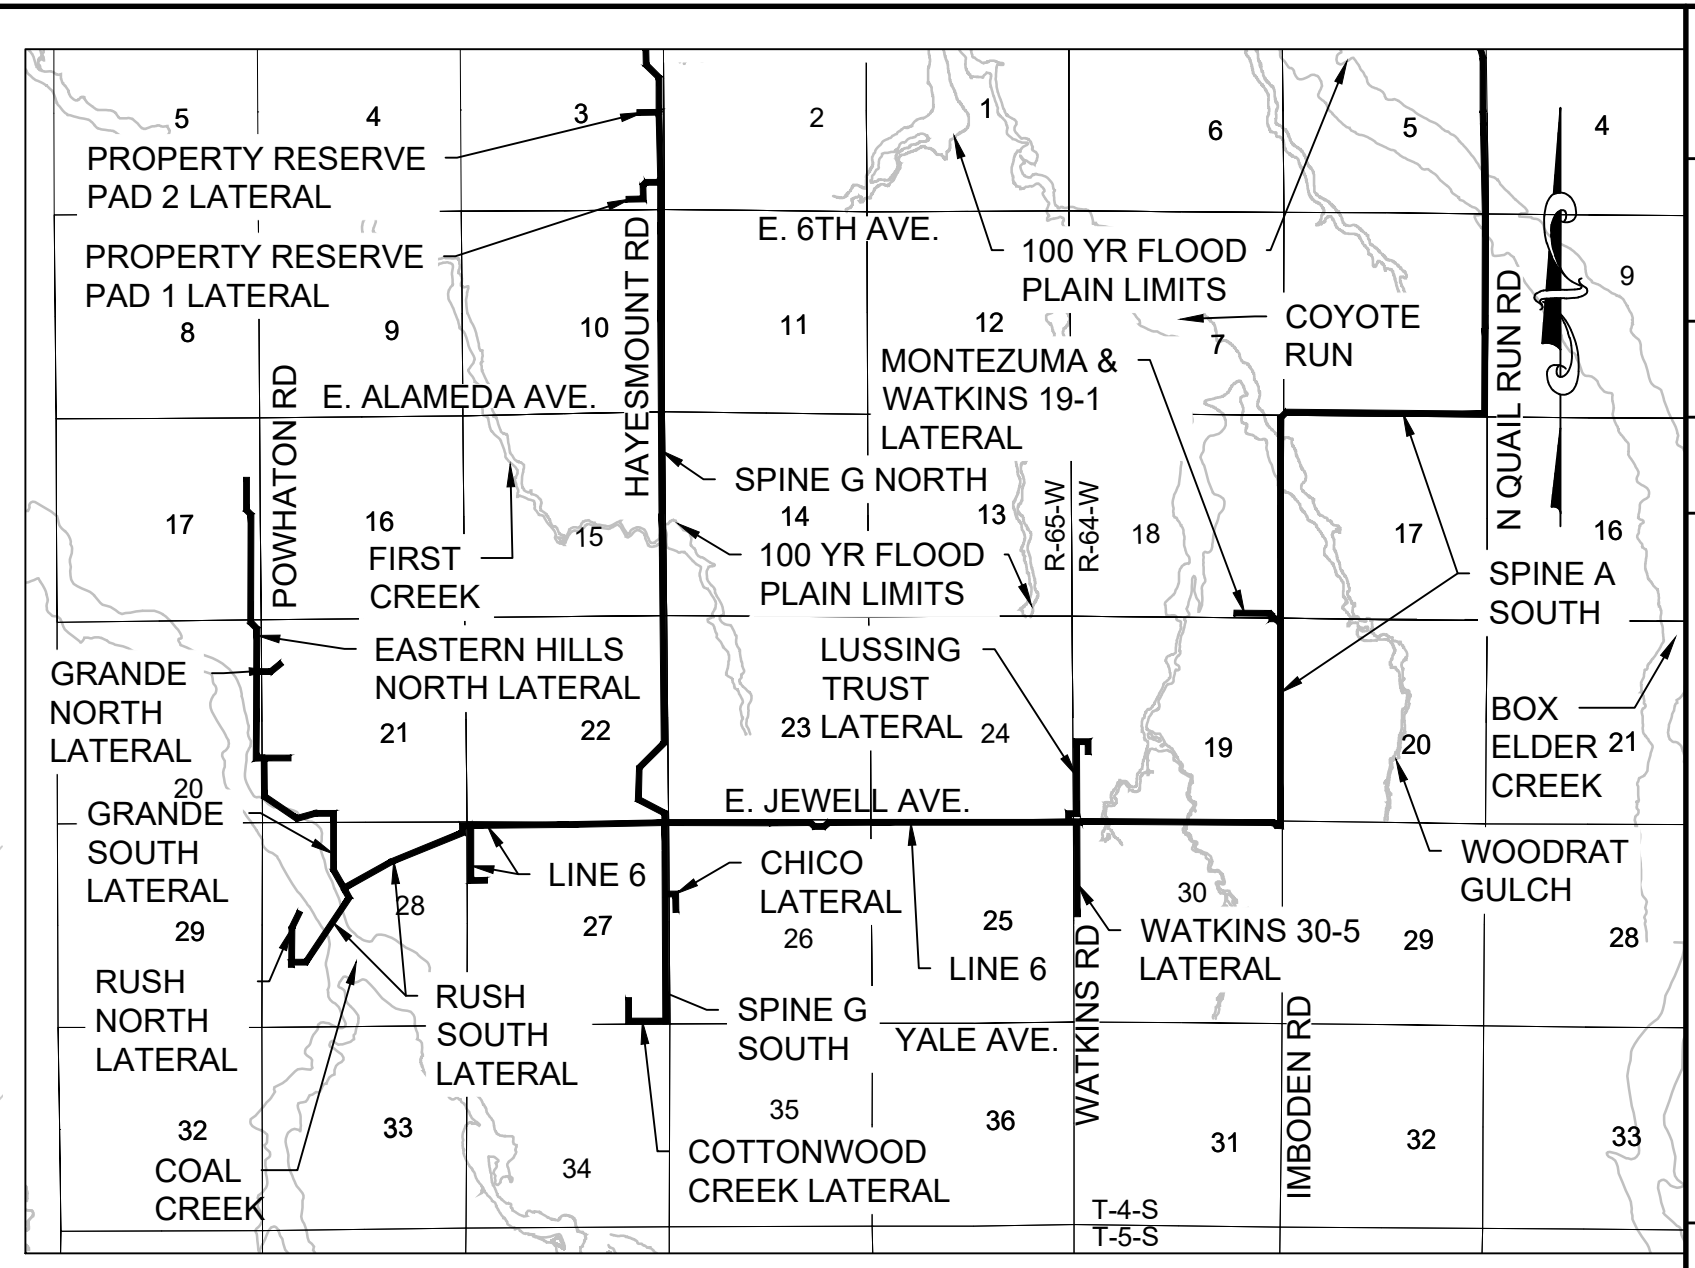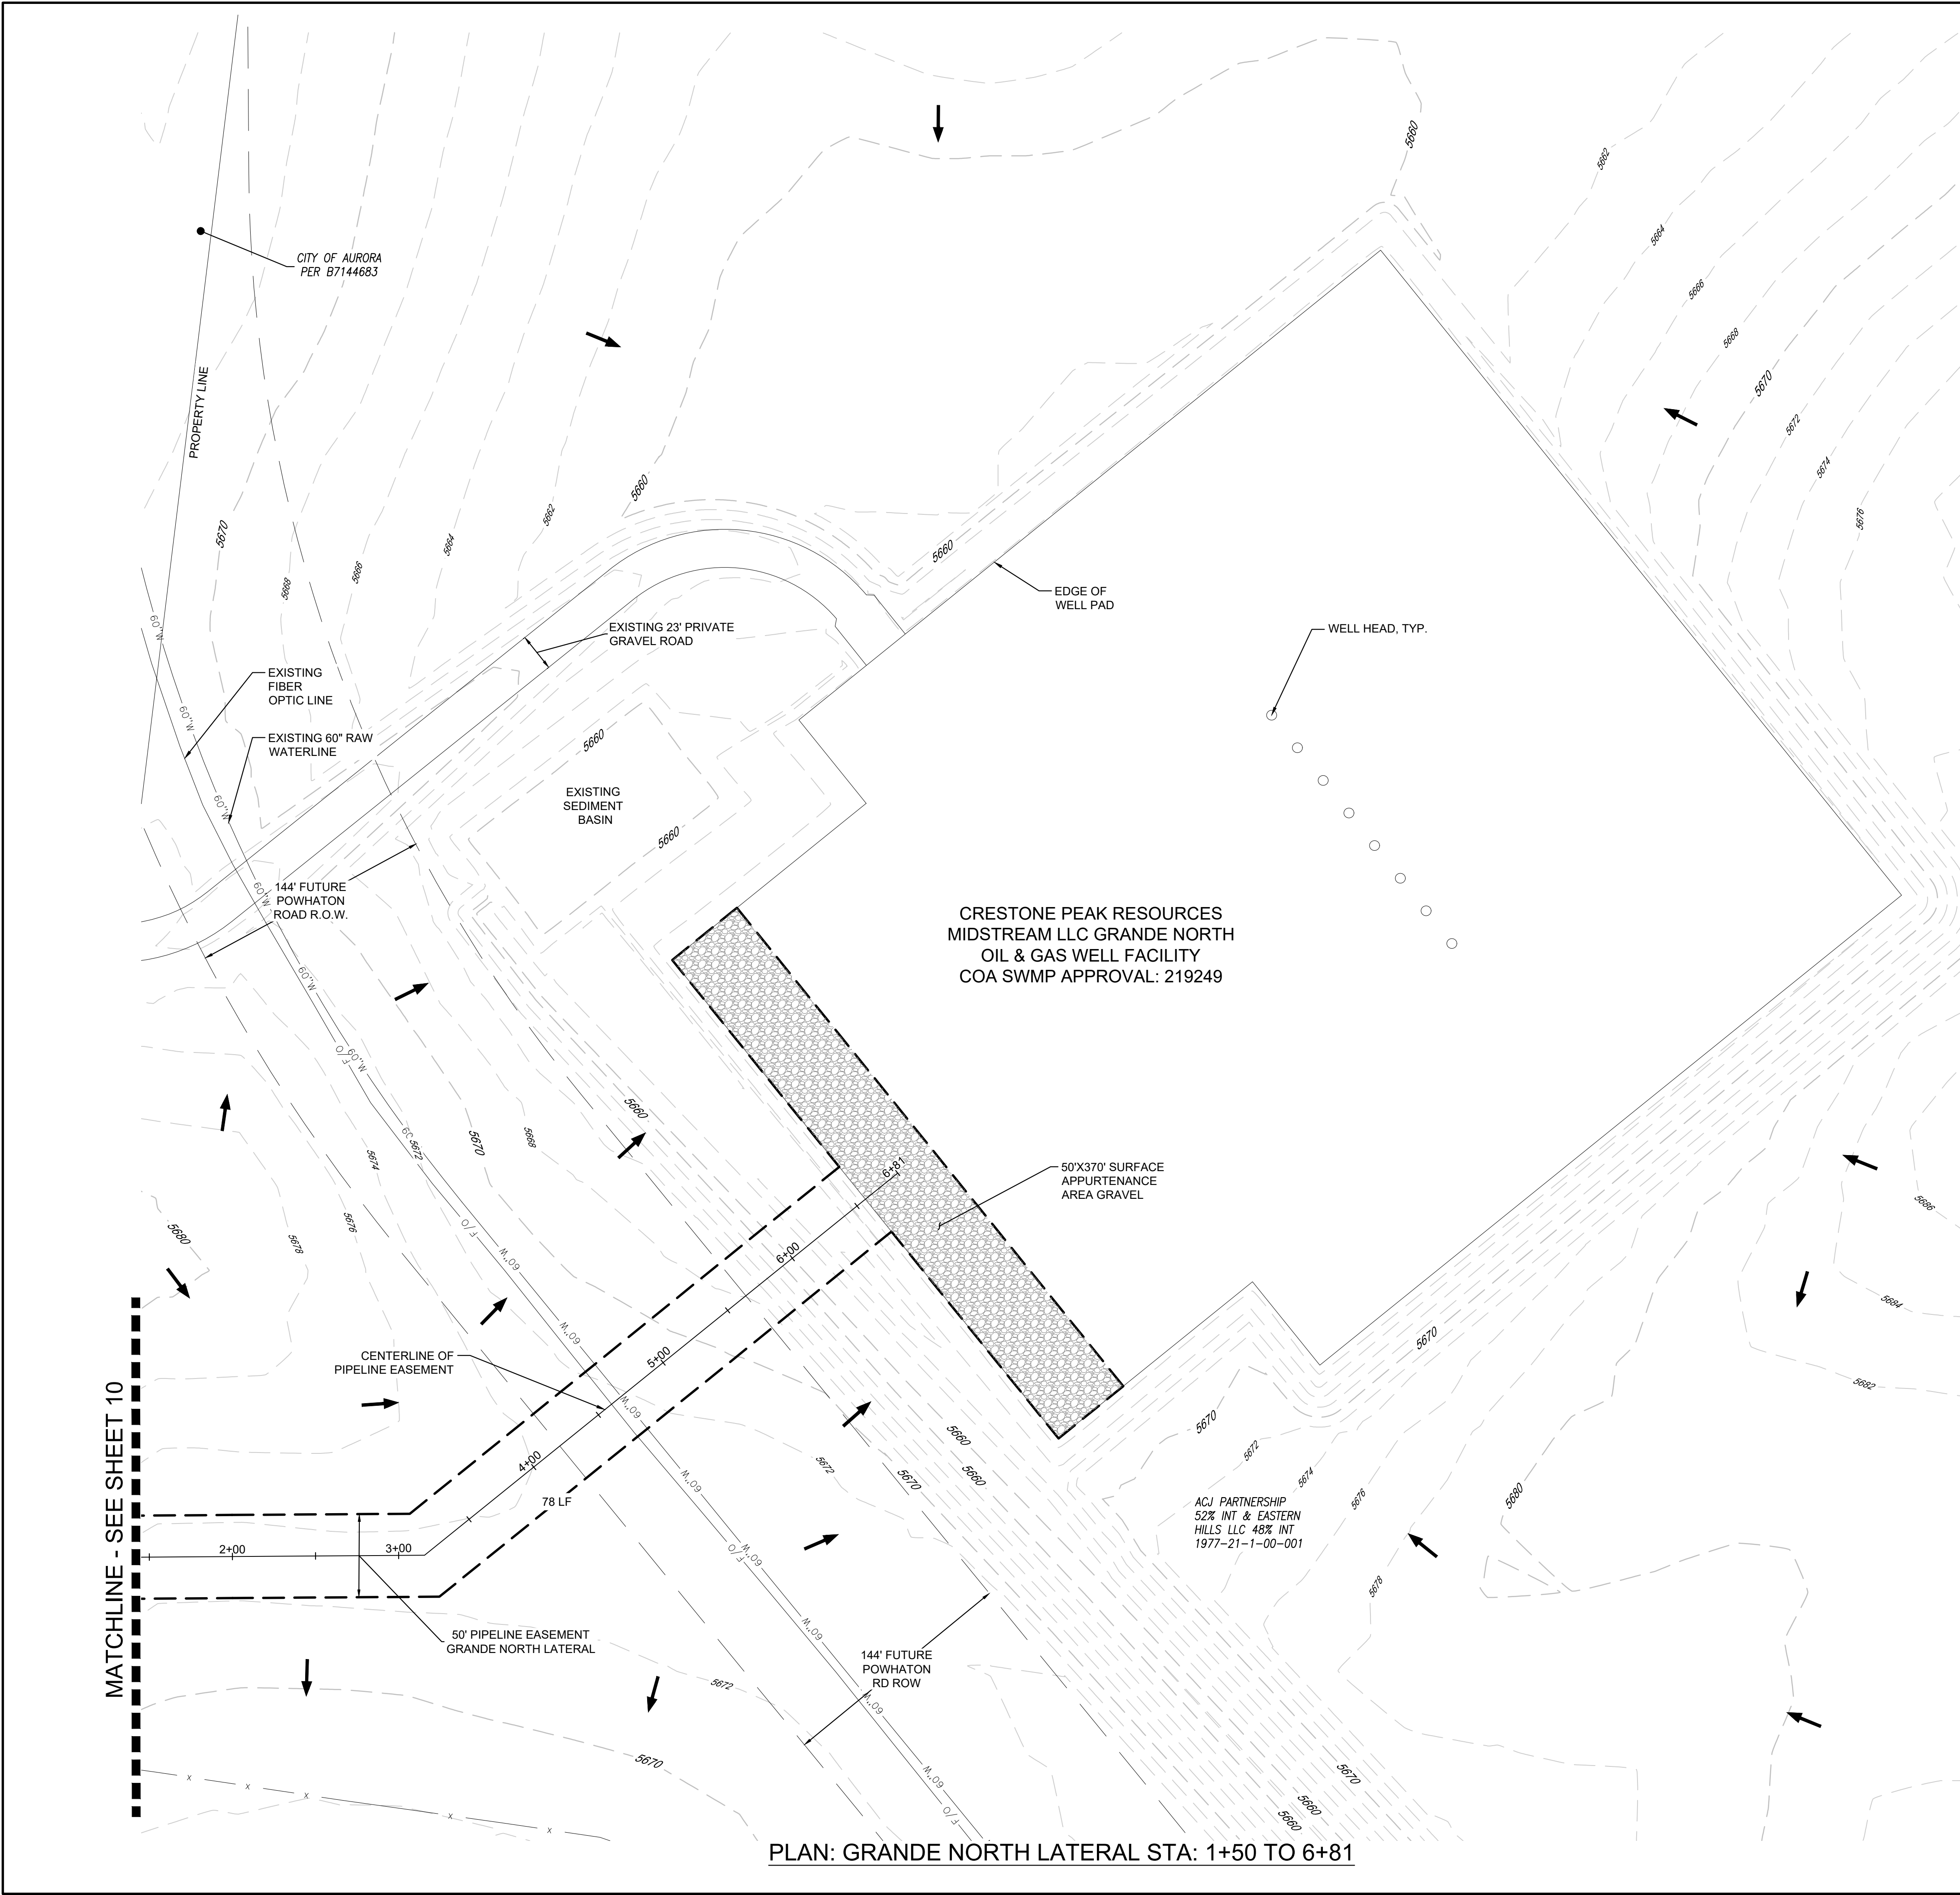

KEY MAP
SCALE: 1" = 5000'

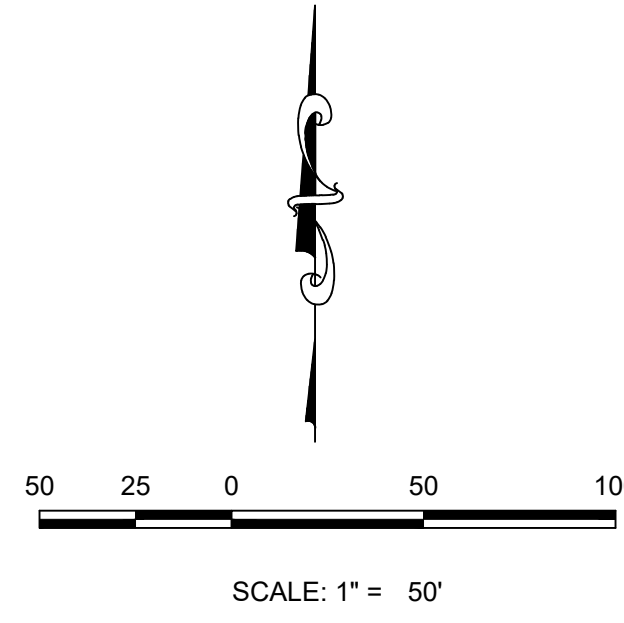

PLAN: GRANDE NORTH LATERAL STA: 1+50 TO 6+81

SHEET NUMBER	DRAWN BY:	KRW	CHECKED BY:	MEL	DATE:	09/24/2021	SCALE:	KRW	AS SHOWN	FILE NO:	8.13.0330001	CRESTONE PEAK PIPELINE GATHERING SYSTEM AS-BUILT SITE PLAN CRESTONE PEAK RESOURCES MIDSTREAM LLC GRANDE NORTH LATERAL 1+50 TO 6+81	CRESTONE PEAK RESOURCES MIDSTREAM LLC ATTN: DAVID STEWART 10168 E. 1-26 FRONTAGE ROAD PUEBLO, CO 81008 PHONE: (303) 774-3809	Westwood 10333 E DRY CREEK RD. SUITE 240 ENGLEWOOD, CO 80152 TEL: 720.482.9526 Westwoodas.com Westwood Professional Services, Inc.	Revisions	No.	Date	Init.	Appr.	Date