



Henry Design Group Response
Comments to PROS redlines;
2021-11-29.

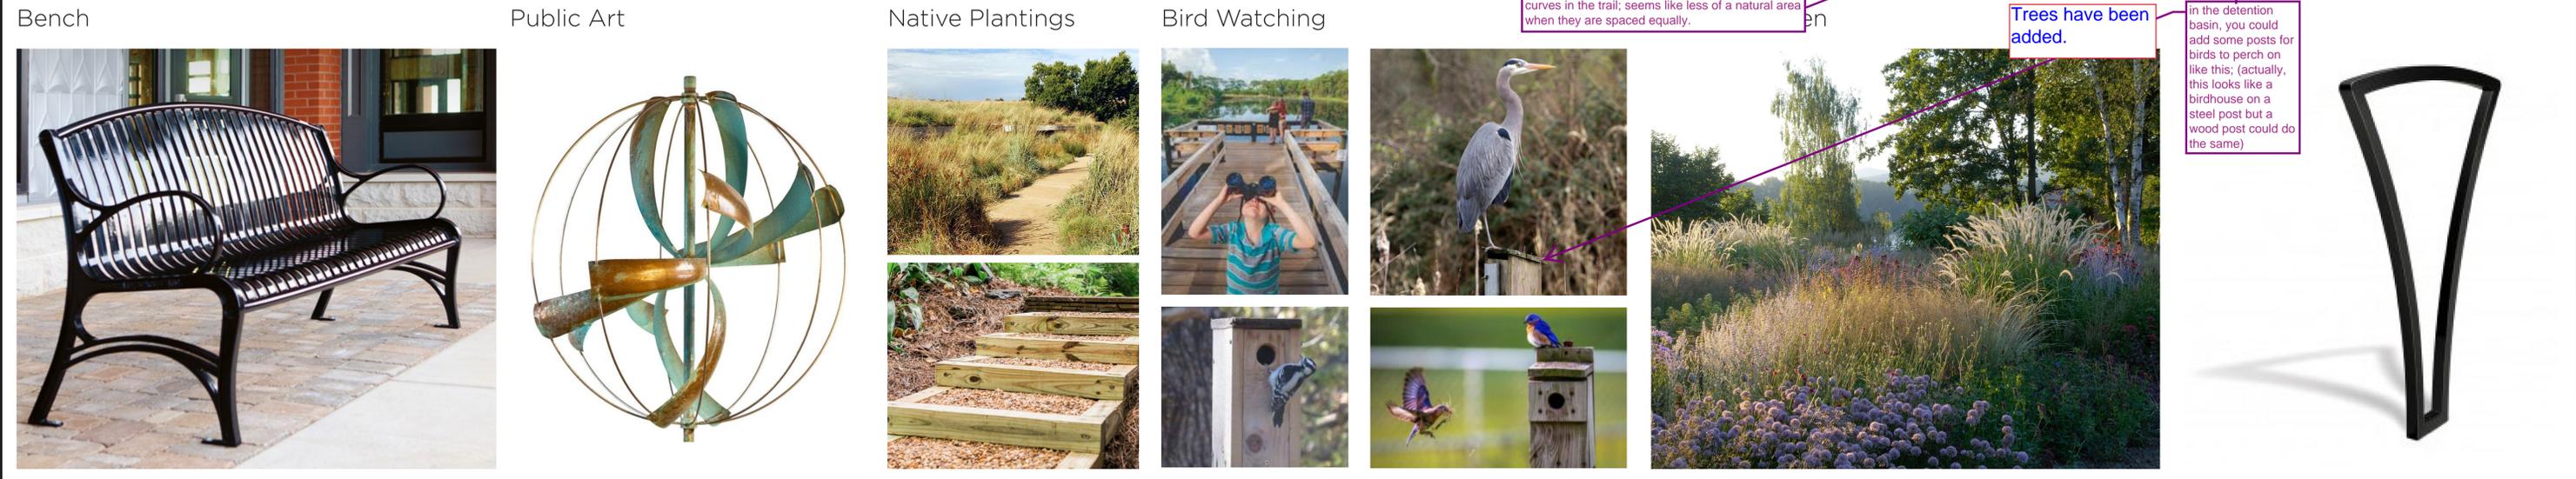

GENERAL NOTE:
LANDSCAPE PLAN DOES NOT
REPRESENT REQUIRED
BUFFERS. TO BE DETERMINED
AT TIME OF CSP.

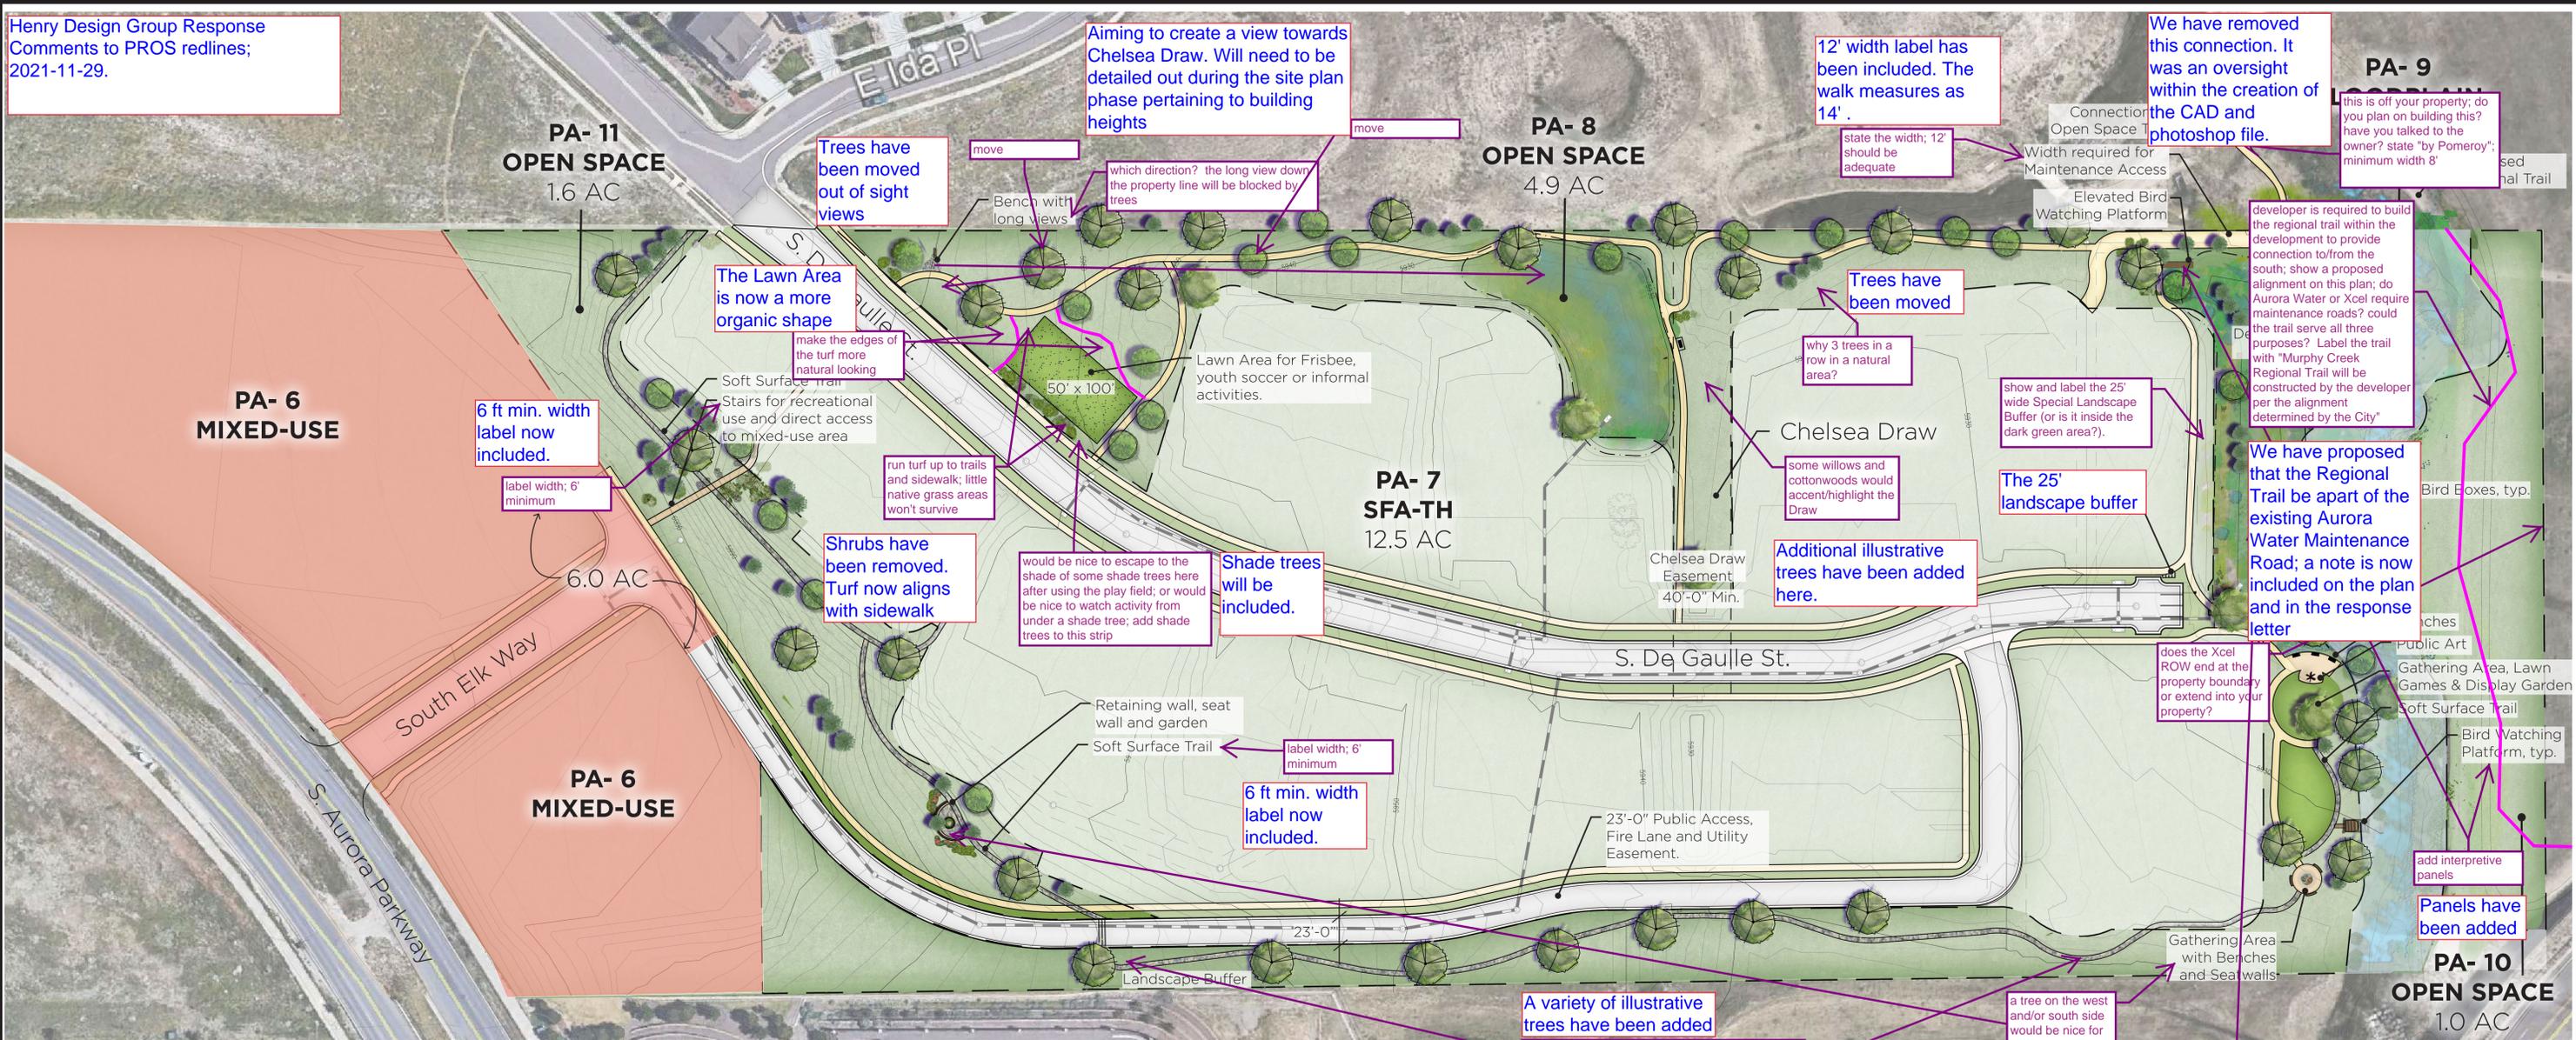

henry
design
group
Landscape Architecture • Planning • Entitlements
1501 Wazee Street Suite 1-C, Denver, Colorado 80202

**SOUTH AURORA PROPERTY
INVESTORS, LLC.**

**POMEROY 1ST AMENDMENT
CONCEPTUAL OPEN SPACE SITE PLAN**

ISSUE DATE: 03/25/21		PROJECT #: 218108	
DATE	REVISION COMMENTS		
10/08/21	FDP RESUBMITTAL		

SHEET NO.
1
1 OF 1