


K:\DEN\_Civil\096649002\_Aurora Car Wash\CADD\PlanSheets\Development\Plan\_649002SP.dwg Felton, Emily 10/30/2020 4:03 PM

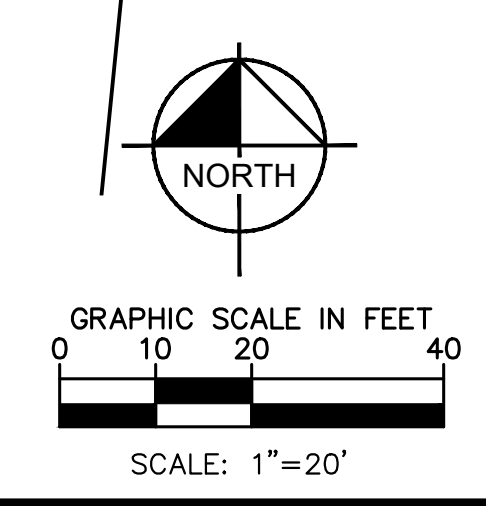

Are the vacuum stations turned off during non-business hours? If so, please add a note on this plan.

(note has been added to plan)

PROJECT NO. 096649002
SHEET NO. 2