

- PIPELINE NOTES:
- TEMPORARY CONSTRUCTION EASEMENT VARIES ON EITHER SIDE OF PIPELINE EASEMENT.
 - EXCAVATED MATERIAL FROM TRENCHES SHALL BE TEMPORARILY STOCKPILED PARALLEL AND UPSTREAM OF THE TRENCH. THESE TEMPORARY STOCKPILES SHALL BE NO STEEPER THAN 2:1
 - PIPELINES CONSTRUCTED THROUGH DRAINAGEWAYS, DEPICTED HEREIN WITH FLOODPLAINS/FLOODWAYS, SHALL PROVIDE 15' OF COVER MINIMUM PER THE VARIANCE GRANTED BY THE CITY OF AURORA. PIPELINES CONSTRUCTED THROUGH DRAINAGEWAYS, DEPICTED HEREIN WITH FLOODPLAINS/FLOODWAYS, WITHIN THE ACRE PARCEL SHALL PROVIDE 10' OF COVER MINIMUM PER THE VARIANCE GRANTED BY THE CITY OF AURORA.
 - PIPELINES CONSTRUCTED THROUGH COLLECTORS, LOCALS, OR ARTERIALS SHALL PROVIDE 10' OF COVER MINIMUM, UNLESS OTHERWISE STATED ON PLANS. IF A CROSSING WILL NOT MEET MINIMUM COVER, A VARIANCE WILL BE REQUIRED.
 - TOTAL LIMITS OF CONSTRUCTION = 249 ACRES.
 - DISTURBED GROUND TO BE RETURNED TO EXISTING ELEVATIONS.
 - PER SECTION 147-11 OF CITY CODE, SINCE THE TRANSFER PUMP SKID STRUCTURES ARE LEASED PROPERTY THEY ARE CONSIDERED A SUBDIVISION PLAT EXCEPTION.
 - THE TRANSFER PUMP SKID STRUCTURE WILL REQUIRE ELECTRICAL AND BUILDING PERMITS TO BE ACQUIRED THROUGH THE CITY OF AURORA BUILDING DIVISION.
 - DJ SOUTH INFELD GATHERING LLC CERTIFIES THAT ALL STRUCTURES ARE IN COMPLIANCE WITH COLORADO STATE REGULATION 8 CCR 1302-14 REGARDING PLACARDING AND CERTIFICATION OF NON-RESIDENTIAL MODULAR OR FACTORY-BUILT STRUCTURES. IN THE EVENT GROUNDWATER IS ENCOUNTERED DURING PIPELINE CONSTRUCTION, CONTRACTOR SHALL NOTIFY JOSHUA GODWIN OF THE CITY OF AURORA JGODWIN@AURORAGOV.ORG (720) 859-4307 AND BE PREPARED TO REPORT THE LOCATION AND DEPTH OF THE GROUNDWATER. ADDITIONALLY, IF DEWATERING OF THE TRENCH IS NECESSARY, A DEWATERING PERMIT FROM COLORADO DEPARTMENT OF PUBLIC HEALTH AND ENVIRONMENT MAY BE REQUIRED.
 - A FLOODPLAIN DEVELOPMENT PERMIT IS REQUIRED FOR ALL WORK WITHIN A FEMA DESIGNATED FLOODPLAIN. FIRM PANEL #S AND EFFECTIVE DATES ARE SHOWN (IF APPLICABLE) ON SHEETS 5-48.
 - WHERE GRAVEL ROADWAYS EXIST TO EXISTING RESIDENCES, PRIVATE ACCESS ROADS WILL BE REPLACED/REPAIRED TO MEET THE PRE-PROJECT CONDITIONS FOLLOWING CONSTRUCTION.
 - DEPICTED DJ SOUTH INFELD GATHERING LLC EQUIPMENT AND BORE PIT ENTRY/EXIT LOCATIONS ARE APPROXIMATE.
 - AS-BUILT DRAWINGS SHALL BE PROVIDED TO THE CITY OF AURORA WITHIN 30 DAYS OF FINAL CONSTRUCTION IN A FORMAT THAT MEETS THE LATEST CITY OF AURORA CAD DATA SUBMITTAL STANDARDS.
 - DUE TO THE LARGE SCOPE OF AREA THAT THIS PIPELINE PROJECT ENTAILS, THERE IS NOT A SINGULAR BENCHMARK THAT APPLIES TO THE ENTIRE PROJECT. A SURVEY CONTROL PLAN IS INCLUDED ON SHEETS 2-5 OF THE CONSTRUCTION PLAN FOR BENCHMARK REFERENCES.
 - ALIGNMENT OF PIPELINE WITHIN ACRE PARCEL IS SUBJECT TO ADDITIONAL INTEGRITY MEASURES. SEE THE IOMS AGREEMENT. LEAK DETECTION SYSTEM TO BE INSTALLED IN THE PIPELINE EASEMENT AND MONITORED ACROSS THE ACRE PARCEL PER THE IOMS AGREEMENT. SHUT OFF VALVES ARE TO BE INSTALLED ON EITHER SIDE OF THE ACRE PARCEL. AURORA WATER (303.326.8645) & DJ SOUTH INFELD GATHERING, LLC (970.534.0705) ARE TO BE NOTIFIED IMMEDIATELY IF ANY LEAKS ARE DETECTED.

- SITE PLAN NOTES:
- ALL SIGNS MUST CONFORM TO THE CITY OF AURORA SIGN CODE.
 - THE APPROVAL OF THIS DOCUMENT DOES NOT CONSTITUTE FINAL APPROVAL OF GRADING, DRAINAGE, UTILITY, PUBLIC IMPROVEMENTS AND BUILDING PLANS. SWMP PLANS MUST BE REVIEWED AND APPROVED BY THE APPROPRIATE AGENCY PRIOR TO THE ISSUANCE OF BUILDING PERMITS.
 - ALL INTERESTED PARTIES ARE HEREBY ALERTED THAT THIS SITE PLAN IS SUBJECT TO ADMINISTRATIVE CHANGES AND AS SHOWN ON THE ORIGINAL SITE PLAN ON FIELD IN THE AURORA CITY PLANNING OFFICE AT THE MUNICIPAL BUILDING. A COPY OF THE OFFICIAL CURRENT PLAN MAY BE PURCHASED THERE. LIKEWISE, SITE PLANS ARE REQUIRED TO AGREE WITH THE APPROVED SUBDIVISION PLAT OF RECORD AT THE TIME OF A BUILDING PERMIT; AND IF NOT MUST BE AMENDED TO AGREE WITH THE PLAT AS NEEDED, OR VICE VERSA.
 - ERRORS IN APPROVED SITE PLANS RESULTING FROM COMPUTATIONS OF INCONSISTENCIES IN THE DRAWINGS MADE BY THE APPLICANT ARE THE RESPONSIBILITY OF THE APPLICANT OF RECORD. WHERE FOUND, THE CURRENT MINIMUM CODE REQUIREMENTS WILL APPLY AT THE TIME OF BUILDING PERMIT. PLEASE BE SURE THAT ALL PLAN COMPUTATIONS ARE CORRECT.
 - ALL REPRESENTATIONS AND COMMITMENTS MADE BY APPLICANT AT PUBLIC HEARINGS, REGARDING THIS PLAN, ARE BINDING UPON THE APPLICANT, AND ITS HEIRS, SUCCESSORS, AND ASSIGNS.
 - THE CITY OF AURORA REQUIRES PLAN AND PROFILES (P&P) OF THE PROPOSED PIPELINE AT CITY OF AURORA RIGHTS-OF-WAY AND EASEMENTS WITH ALL LICENSE AGREEMENTS AND CIVIL PLAN SUBMITTALS. THE P&PS SHALL SHOW ALL EXISTING AND KNOWN PROPOSED UTILITIES WITH VERIFIED ELEVATIONS BASED ON PRE-DESIGN POT-HOLING, AND DEMONSTRATE THE REQUIRED MINIMUM HORIZONTAL AND VERTICAL UTILITY CLEARANCES ARE BEING MET.
 - THE GATHERING SYSTEM AND FLOWLINE WILL NOT HAVE ANY UNDUE ADVERSE EFFECTS ON EXISTING AND FUTURE DEVELOPMENT OF THE SURROUNDING AREA AS SET FORTH IN APPLICABLE CITY MASTER PLANS. THE DESIGN OF THE PROPOSED GATHERING SYSTEM AND FLOWLINE MITIGATES NEGATIVE IMPACTS ON THE SURROUND AREA TO THE GREATEST EXTENT FEASIBLE. THE DISTURBED AREA SHALL BE MAINTAINED DURING CONSTRUCTION BY THE APPLICANT OR PROPERTY OWNER IN SUCH A MANNER TO CONTROL SOIL EROSION, DUST AND THE GROWTH OF NOXIOUS WEEDS.
 - ALL AMENDMENTS TO THIS SITE PLAN SHALL UTILIZE EASEMENTS THAT DO NOT SIGNIFICANTLY ENCUMBER CURBSIDE LANDSCAPING OR STREET FRONTAGE LANDSCAPE BUFFERS FOR FUTURE DEVELOPMENTS. THIS CAN BE DONE BY EITHER LOCATING ALL EASEMENTS OUTSIDE OF THESE IDENTIFIED AREAS OR INCLUDING EASEMENT LANGUAGE THAT ALLOWS SUFFICIENT PLANTINGS (AS DETERMINED BY THE CITY LANDSCAPE ARCHITECT) TO BE INSTALLED WITHIN EASEMENTS.

CRUDE OIL PIPELINE - SITE PLAN

DJ SOUTH INFELD GATHERING LLC

THIS SITE PLAN AND ANY AMENDMENTS HERETO, UPON APPROVAL BY THE CITY OF AURORA AND RECORDING, SHALL BE BINDING UPON THE APPLICANTS THEREFORE, THEIR SUCCESSORS AND ASSIGNS. THIS PLAN SHALL LIMIT AND CONTROL THE ISSUANCE AND VALIDITY OF ALL BUILDING PERMITS, AND SHALL RESTRICT AND LIMIT THE CONSTRUCTION, LOCATION, USE, OCCUPANCY AND OPERATION OF ALL LAND AND STRUCTURES WITHIN THIS PLAN TO ALL CONDITIONS, REQUIREMENTS AND NOTATIONS SET FORTH HEREIN. ABANDONMENT, WITHDRAWAL OR AMENDMENT OF THIS PLAN MAY BE PERMITTED ONLY UPON APPROVAL OF THE CITY OF AURORA.

IN WITNESS WHEREOF, _____ HAS CAUSED THESE
(CORPORATION, COMPANY, OR INDIVIDUAL)

PRESENTS TO BE EXECUTED THIS _____ DAY OF _____ AD, 20____.

BY: _____
(PRINCIPALS OR OWNERS)

STATE OF _____ JSS

COUNTY OF _____

THE FOREGOING INSTRUMENT WAS ACKNOWLEDGED BEFORE ME THIS _____ DAY OF _____ AD, 20____ BY

(PRINCIPALS OR OWNERS)

WITNESS MY HAND AND SEAL

(NOTARY PUBLIC)

MY COMMISSION EXPIRES: _____


NOTARY BUSINESS ADDRESS _____

CRUDE OIL PIPELINE - SITE PLAN

DJ SOUTH INFELD GATHERING LLC

SECTIONS 19, 20, 29, 30, 32, 33, & 34, TOWNSHIP 3 SOUTH, RANGE 64 WEST, SECTIONS 15, 22, 25, 26, 27, & 34, TOWNSHIP 3 SOUTH, RANGE 65 WEST, OF THE SIXTH PRINCIPAL MERIDIAN, CITY OF AURORA, ADAMS COUNTY, STATE OF COLORADO

SECTIONS 3, 15, 17, 20, 21, 22, 25, 26, 27 & 28, TOWNSHIP 4 SOUTH, RANGE 65 WEST, SECTIONS 18, 19 & 30, TOWNSHIP 4 SOUTH, RANGE 64 WEST OF THE SIXTH PRINCIPAL MERIDIAN, CITY OF AURORA, ARAPAHOE COUNTY, STATE OF COLORADO

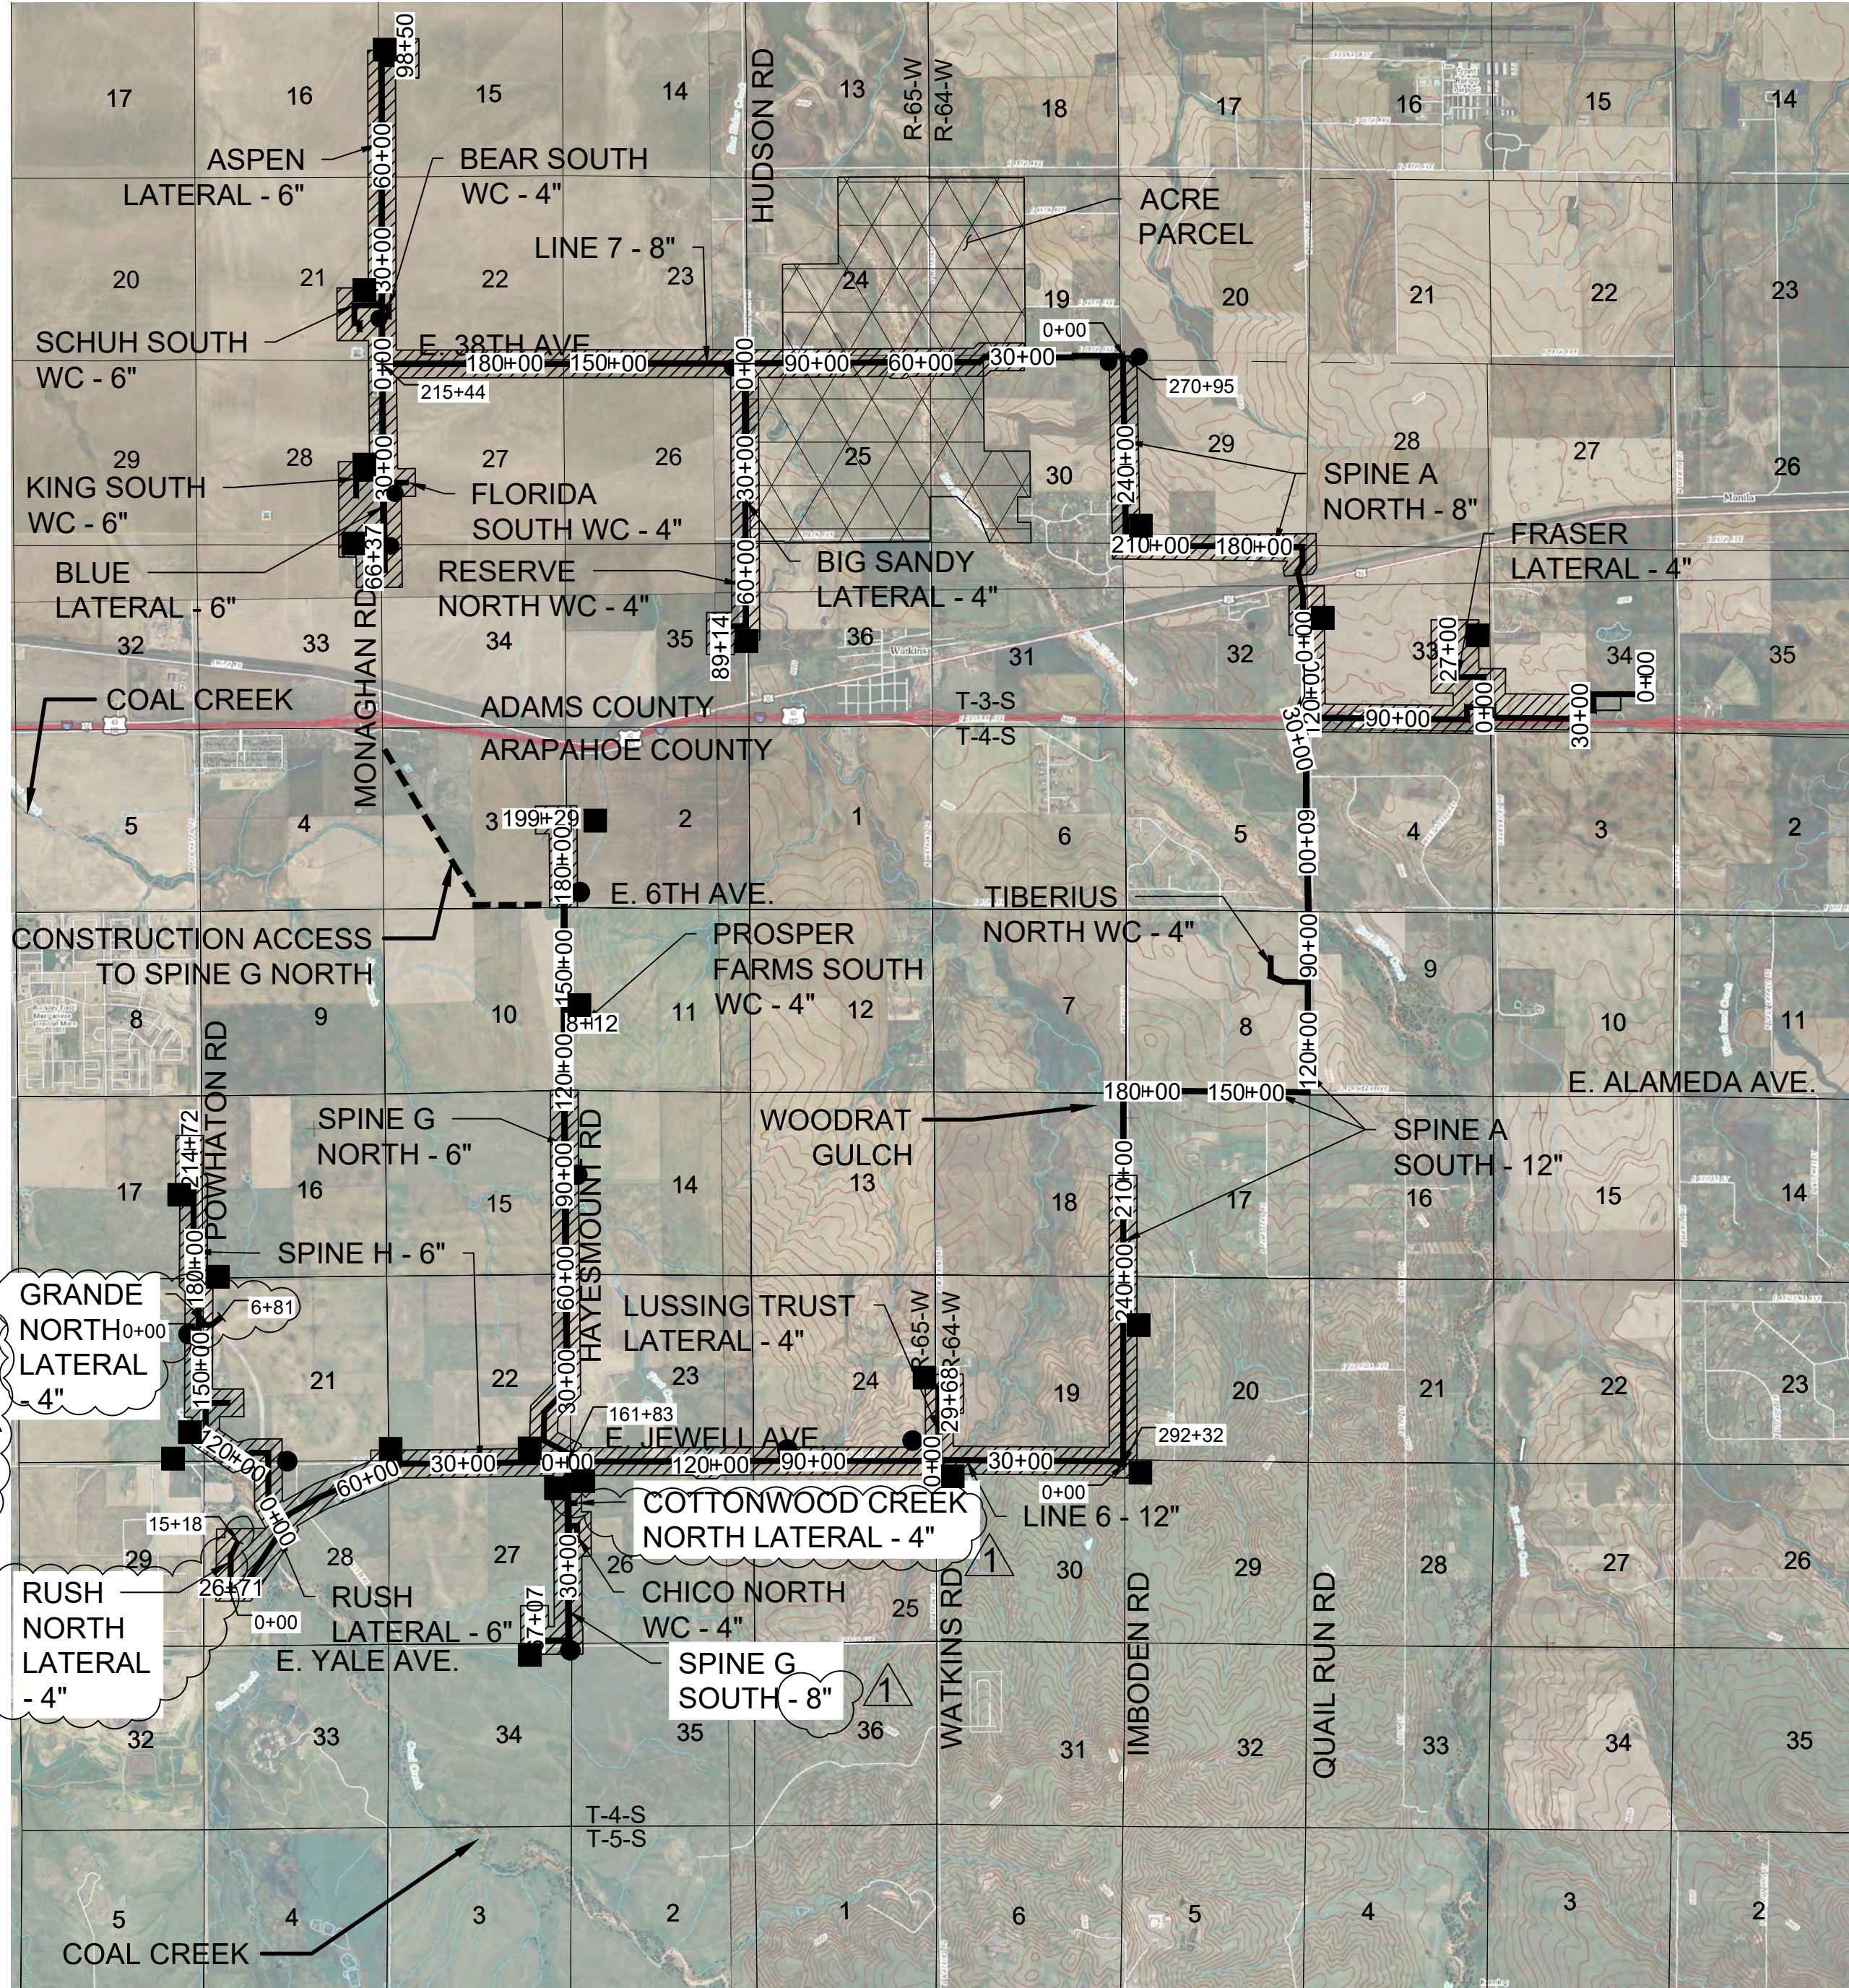

VICINITY MAP NOTES:

- PIPELINE ALIGNMENTS HATCHED WITH ARE WITHIN THE CITY OF AURORA. PIPELINE ALIGNMENTS NOT HATCHED ARE OUTSIDE OF THE JURISDICTIONAL BOUNDARIES OF THE CITY OF AURORA.

VICINITY MAP

SCALE: 1" = 4,000 FT.

● CONSTRUCTION ACCESS ■ PERMANENT ACCESS

CITY OF AURORA APPROVALS

CITY ATTORNEY: _____ DATE: _____
PLANNING DIRECTOR: _____ DATE: _____
PLANNING COMMISSIONER: _____ DATE: _____
CITY COUNCIL: _____ DATE: _____
ATTEST: _____ DATE: _____
(CITY CLERK)
DATABASE APPROVAL DATE: _____

COUNTY RECORDATION

RECORDER'S CERTIFICATE:
ACCEPTED FOR FILING IN THE OFFICE OF THE CLERK AND RECORDER OF COLORADO AT _____ O'CLOCK _____ M, THIS _____ DAY OF _____ AD, _____
CLERK AND RECORDER _____ DEPUTY: _____

AMENDMENTS:

- 09/17/21 - COTTONWOOD CREEK NORTH LATERAL (300 FEET) - SPINE G SOUTH DIAMETER ADJUSTMENT TO 8"
- 09/18/21 - RUSH NORTH LATERAL (1,500 FEET)
- 09/19/21 - GRANDE NORTH LATERAL (700 FEET)

SHEET INDEX

- COVER SHEET
- AURORA ZONING MAP
- AURORA NEIGHBORHOOD MAP
- APPURTENANCE SITE & FEMA FLOODPLAIN MAP
- SPINE G SOUTH 67+07 TO 33+00
- SPINE G SOUTH 33+00 TO 16+00 & CHICO NORTH WC
- SPINE G SOUTH 16+00 TO 0+00 SPINE G NORTH 0+00 TO 8+50 & COTTONWOOD CREEK NORTH 0+00 TO 2+72
- SPINE G NORTH 8+50 TO 26+00
- SPINE G NORTH 26+00 TO 63+00
- SPINE G NORTH 63+00 TO 109+50
- SPINE G NORTH 109+50 TO 116+50 & 166+00 TO 191+50
- SPINE G NORTH 191+50 TO 198+80
- RUSH LATERAL 26+71 TO 4+00 & RUSH NORTH LATERAL 0+00 TO 4+00
- RUSH LATERAL 4+00 TO 0+00 & SPINE H 86+50 TO 112+00
- SPINE H 112+00 TO 136+00
- SPINE H 136+00 TO 167+00 & GRANDE NORTH 0+00 TO 1+50
- SPINE H 167+00 TO 191+50
- SPINE H 101+50 TO 214+72
- SPINE H 86+50 TO 55+50
- SPINE H 55+50 TO 17+50
- SPINE H 17+50 TO 0+00 & LINE 6 161+83 TO 142+00
- LINE 6 142+00 TO 104+5023 - LINE 6 104+50 TO 58+00
- LINE 6 58+00 TO 51+50 & LUSSING TRUST LATERAL 0+00 TO 29+68
- LINE 6 51+50 TO 3+50
- LINE 6 3+50 TO 0+00 & SPINE A SOUTH 292+32 TO 256+50
- SPINE A SOUTH 256+50 TO 209+50
- BLUE LATERAL 66+37 TO 39+00
- BLUE LATERAL 39+00 TO 29+00, FLORIDA SOUTH WC, & KING SOUTH
- BLUE LATERAL 29+00 TO 0+00, ASPEN LATERAL 0+00 TO 7+00, & LINE 7 215+44 TO 213+50
- ASPEN LATERAL 7+00 TO 17+50, SCHUH SOUTH WC, & BEAR SOUTH WC
- ASPEN LATERAL 17+50 TO 68+50
- ASPEN LATERAL 68+50 TO 98+50
- LINE 7 213+50 TO 164+00
- LINE 7 164+00 TO 115+50
- LINE 7 115+50 TO 69+00 & BIG SANDY LATERAL 0+00 TO 2+00
- LINE 7 69+00 TO 27+00
- BIG SANDY LATERAL 0+00 TO 38+00
- BIG SANDY LATERAL 38+00 TO 72+50
- BIG SANDY LATERAL 72+50 TO 89+10
- SPINE A NORTH 270+95 TO 231+00
- SPINE A NORTH 231+00 TO 198+00
- SPINE A NORTH 198+00 TO 163+00
- SPINE A NORTH 163+00 TO 141+50
- SPINE A NORTH 141+50 TO 111+00
- SPINE A NORTH 111+00 TO 68+50
- SPINE A NORTH 68+50 TO 26+00 & FRAESR LATERAL 0+00 TO 1+00
- FRASER LATERAL 1+00 TO 27+00
- TRANSFER PUMP SKID DETAILS
- TRANSFER PUMP SKID DETAILS
- TRANSFER PUMP SKID DETAILS
- LAUNCHER DETAILS
- LAUNCHER DETAILS
- CITY OF AURORA FUTURE ROW CROSS SECTIONS
- RUSH NORTH LATERAL 4+00 TO 15+18
- GRANDE NORTH LATERAL 1+50 TO 6+81

ACCESS ROAD AND PAD CONSTRUCTION NOTE:


ACCESS ROAD AND PAD CONSTRUCTION SHALL BE DESIGNED AND MAINTAINED TO SUPPORT THE IMPOSED LOADS OF FIRE APPARATUS (85,000 LBS) UTILIZING THE CDOT ROAD-BASE #6 SPECIFICATION TO PROVIDE FOR ALL WEATHER DRIVING CAPABILITIES. THE ACCESS ROAD SHALL BE 23' WIDE WITH A 29' INSIDE TURNING RADIUS. WHILE CDOT #6 IS SPECIFIED, THE MATERIAL USED TO CONSTRUCT THESE SURFACES MAY BE OF ANY ONE OF, OR A COMBINATION OF, SEVERAL AGGREGATE MATERIALS AVAILABLE. APPROVED MATERIALS INCLUDE: PREMIUM ROAD BASE MATERIAL, 1-1.5 ANGULAR INCH RIVER ROCK, CRUSHED GRANITE, OR OTHER AGGREGATE WITH NOT LESS THAN ONE-INCH NOMINAL SIZE DESIGNATION AND CDOT ROAD BASE CLASS 6.


LEGEND



(LOC)	LIMITS OF CONSTRUCTION	
(VTC)	VEHICLE TRACKING CONTROL	
	WILDLIFE FENCE	— X — X —
	GRAVEL	
	EXISTING EASEMENT	— — — —
	PROPOSED EASEMENT	— — — —
	FENCE	— X —
	SECTION LINE	— — — —
	OVERHEAD POWER LINE	— OHP — OHP —
	PROPOSED MAJOR CONTOURS	— — — —
	EXISTING MAJOR CONTOURS	— — — —
	SIGHT DISTANCE LINE	— — — —



 CALL 811
TWO WORKING DAYS
BEFORE YOU DIG
1-800-922-1987

SHEET NUMBER <div>1</div>	DRAWN BY: KRW	SCALE: AS SHOWN	CRUDE OIL PIPELINE DJ SOUTH INFIELD GATHERING LLC CITY OF AURORA SITE PLAN COVER SHEET	DJ SOUTH INFIELD GATHERING, LLC ATTN: AMANDA MARTIN 1600 BROADWAY, SUITE 2400 DENVER, CO 80202 PHONE: (720) 381-2955	 CML CONSULTANTS CIVIL ENGINEERING LAND SURVEYING	10333 E. Dry Creek Rd. Suite 240 Englewood, CO 80152 Phone: (720) 482-9526 Fax: (720) 482-9546	Revisions			
	CHECKED BY: MEL	FILE NO.					No.			
	DATE: 08/22/20	8.13.0325701								

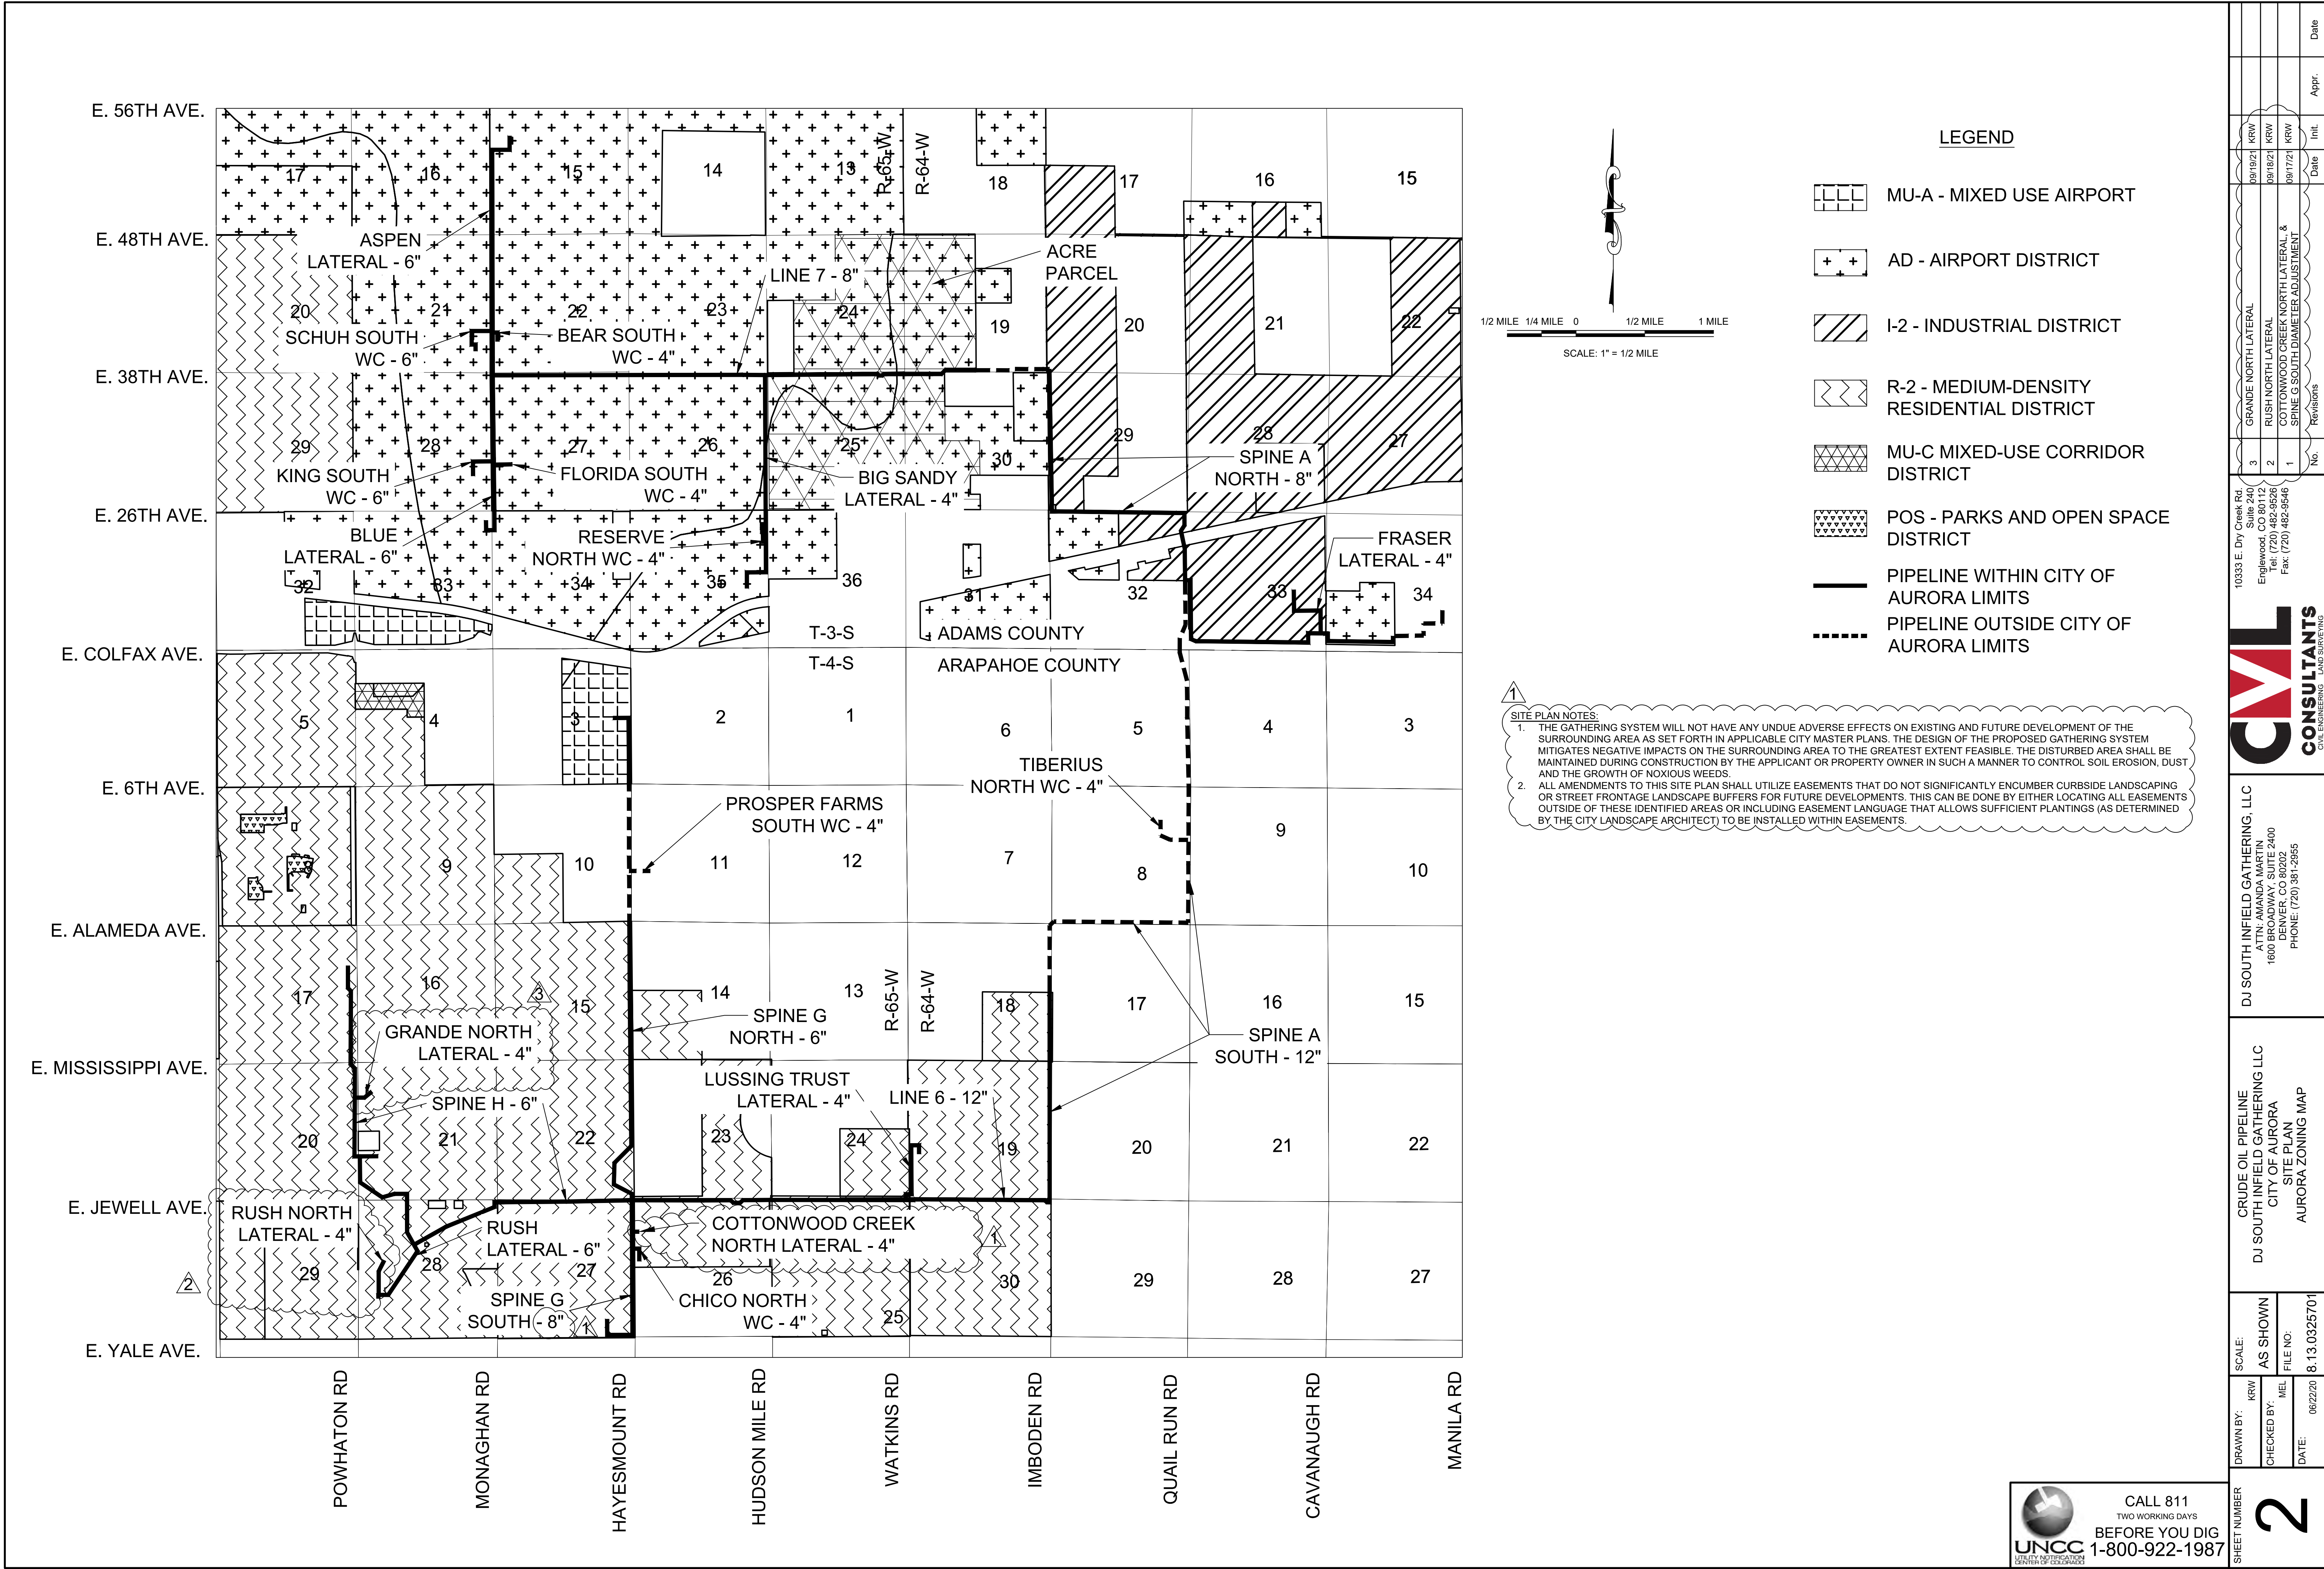

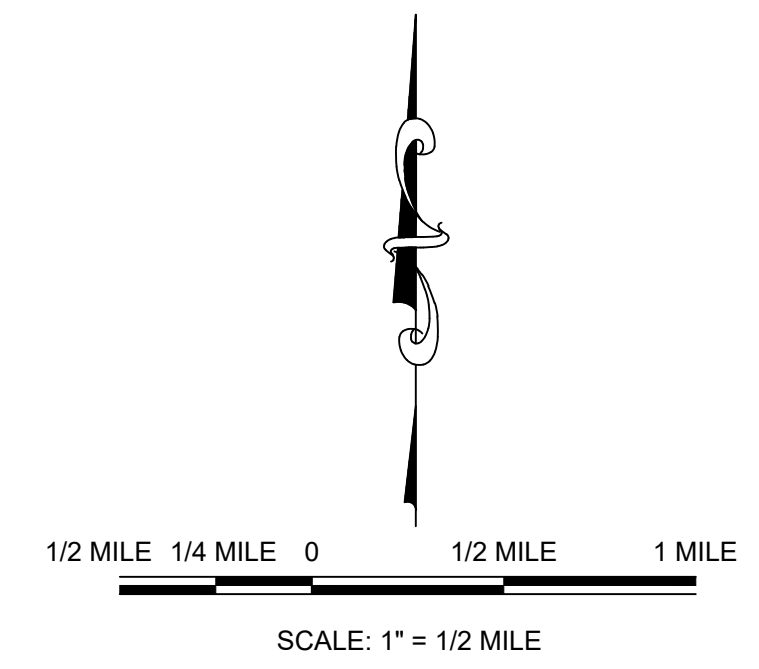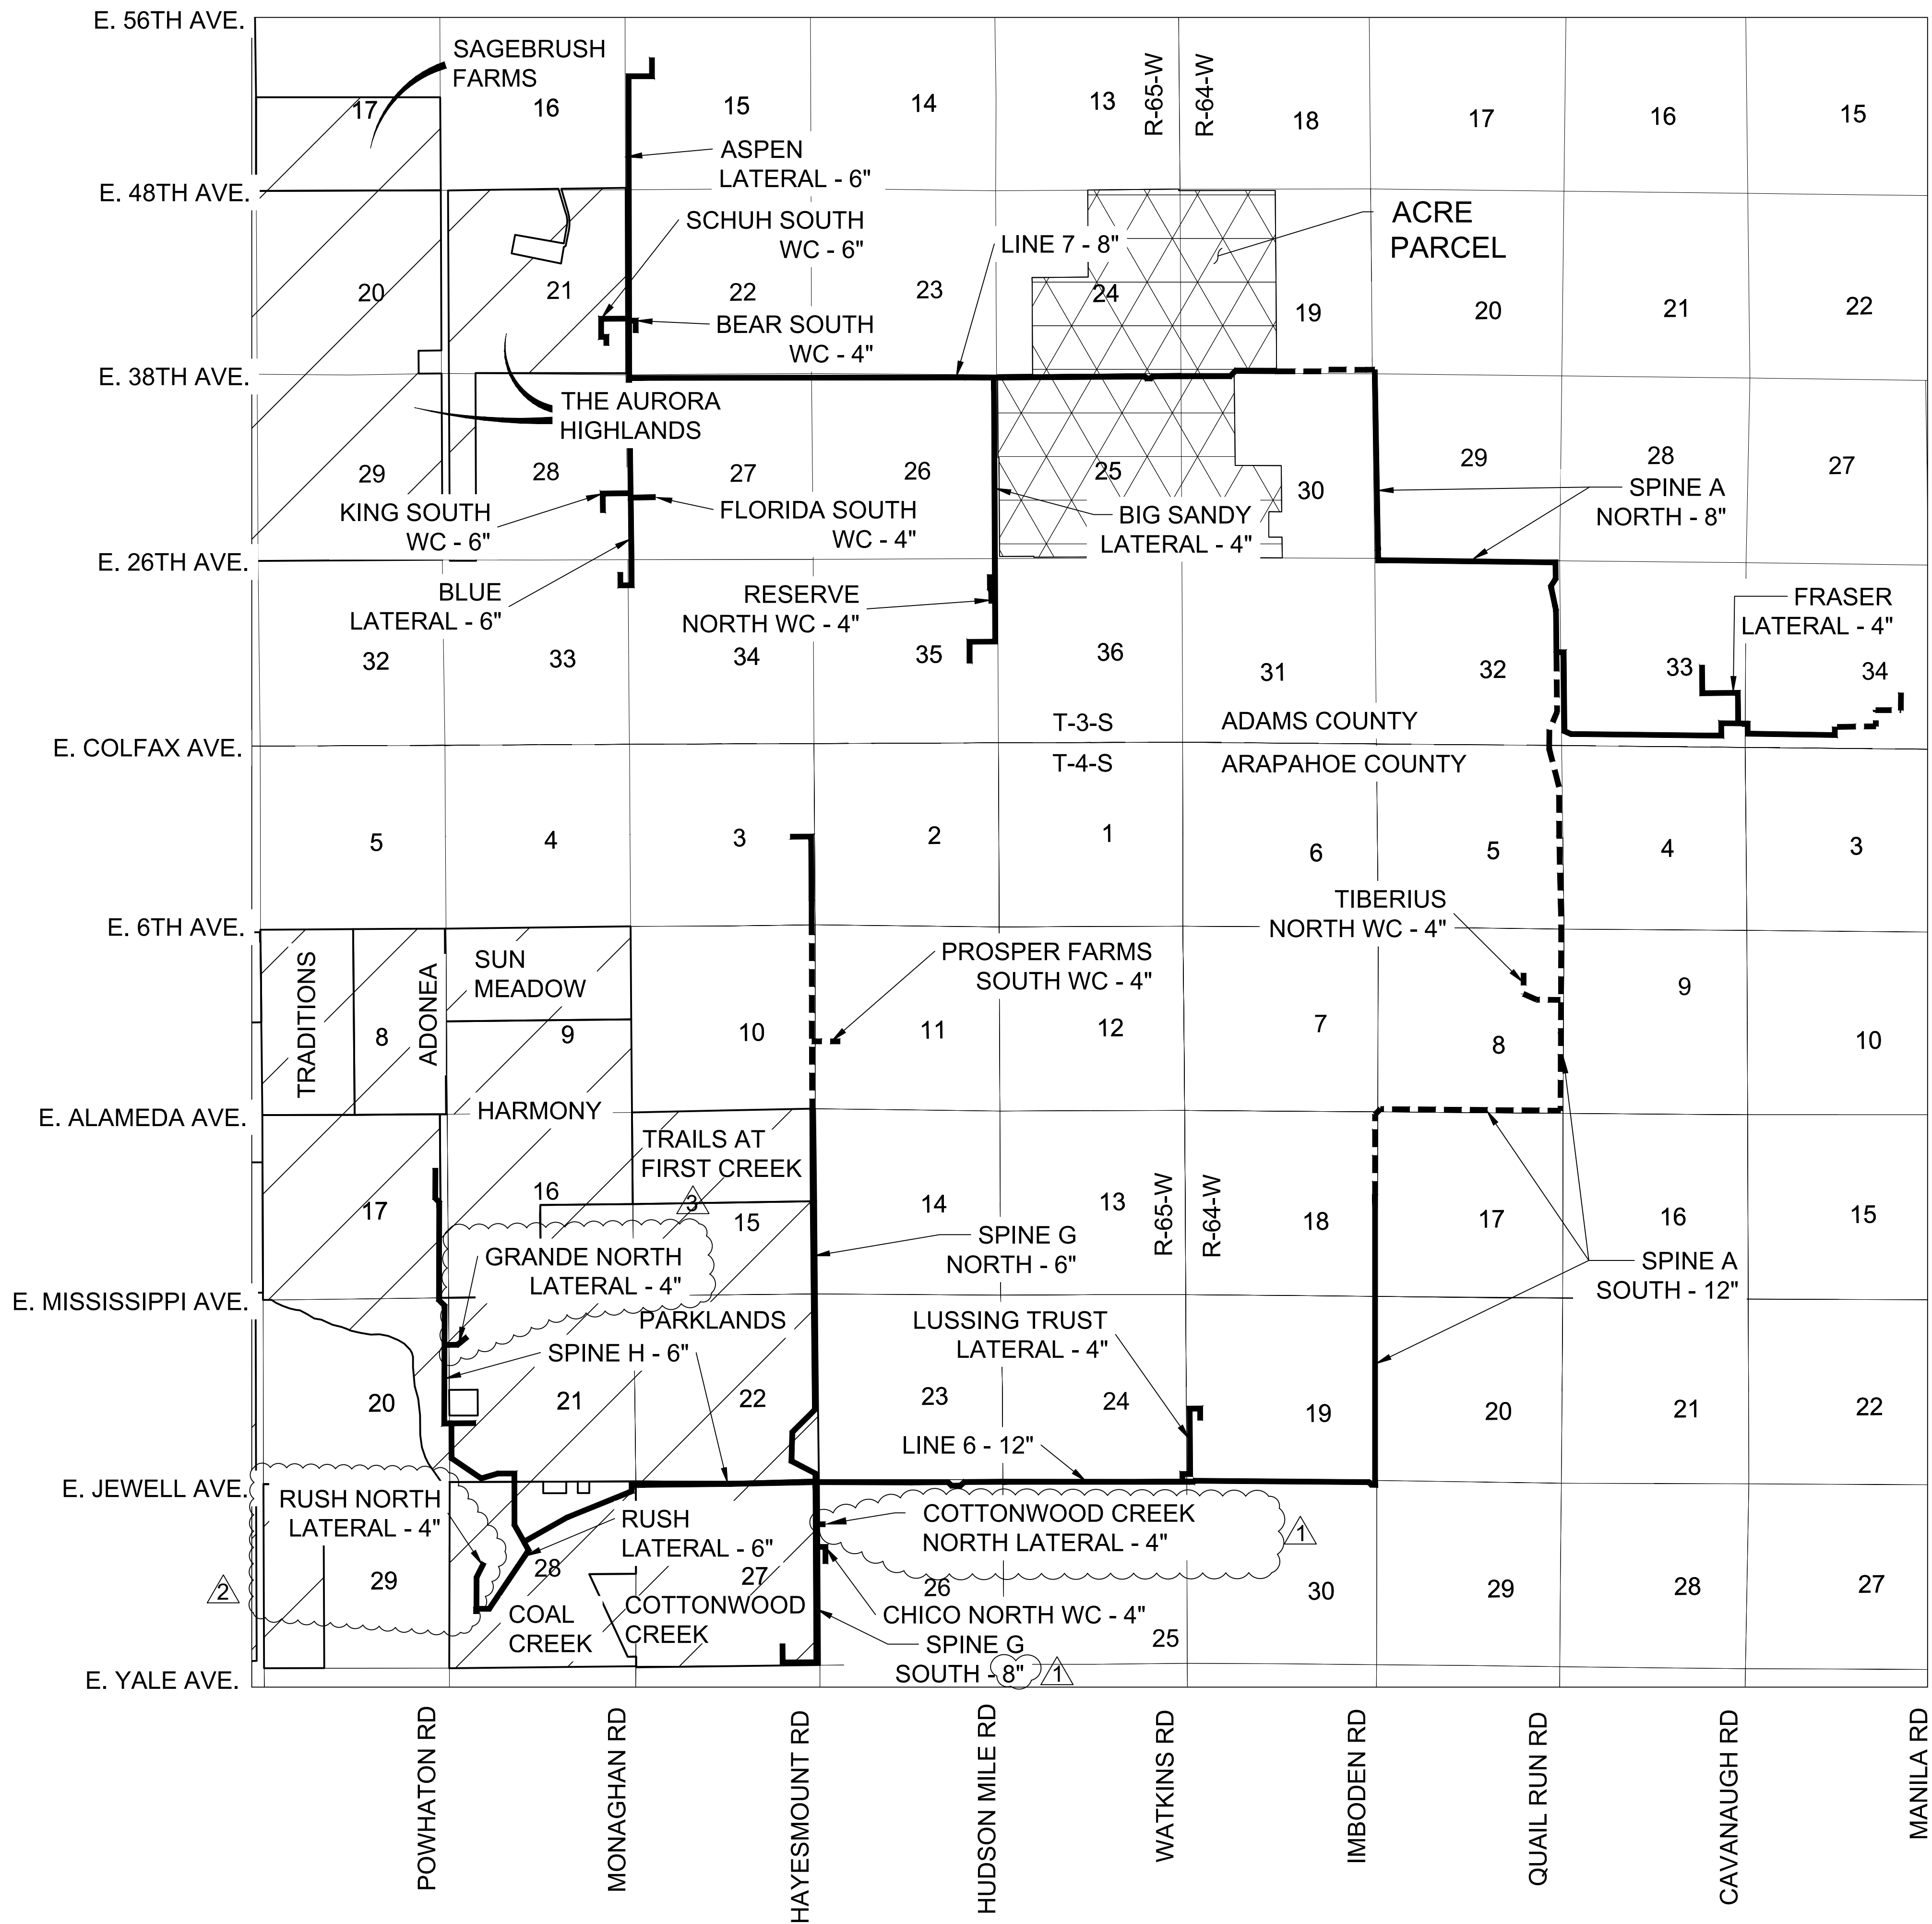

SITE PLAN NOTES:



1. THE GATHERING SYSTEM WILL NOT HAVE ANY UNDUE ADVERSE EFFECTS ON EXISTING AND FUTURE DEVELOPMENT OF THE SURROUNDING AREA AS SET FORTH IN APPLICABLE CITY MASTER PLANS. THE DESIGN OF THE PROPOSED GATHERING SYSTEM MITIGATES NEGATIVE IMPACTS ON THE SURROUNDING AREA TO THE GREATEST EXTENT FEASIBLE. THE DISTURBED AREA SHALL BE MAINTAINED DURING CONSTRUCTION BY THE APPLICANT OR PROPERTY OWNER IN SUCH A MANNER TO CONTROL SOIL EROSION, DUST AND THE GROWTH OF NOXIOUS WEEDS.
2. ALL AMENDMENTS TO THIS SITE PLAN SHALL UTILIZE EASEMENTS THAT DO NOT SIGNIFICANTLY ENCUMBER CURBSIDE LANDSCAPING OR STREET FRONTAGE LANDSCAPE BUFFERS FOR FUTURE DEVELOPMENTS. THIS CAN BE DONE BY EITHER LOCATING ALL EASEMENTS OUTSIDE OF THESE IDENTIFIED AREAS OR INCLUDING EASEMENT LANGUAGE THAT ALLOWS SUFFICIENT PLANTINGS (AS DETERMINED BY THE CITY LANDSCAPE ARCHITECT) TO BE INSTALLED WITHIN EASEMENTS.

LEGEND

- EXISTING NEIGHBORHOOD
- PIPELINE WITHIN CITY OF AURORA LIMITS
- PIPELINE OUTSIDE CITY OF AURORA LIMITS

CALL 811
TWO WORKING DAYS
BEFORE YOU DIG
UNCC 1-800-922-1987
UTILITY NOTIFICATION
CENTER OF COLORADO

SHEET NUMBER 3	DRAWN BY: KRW	CHECKED BY: MEL	DATE: 06/22/20	SCALE: AS SHOWN FILE NO: 8.13.0325701	CRUDE OIL PIPELINE DJ SOUTH INFILDE GATHERING LLC CITY OF AURORA SITE PLAN AURORA NEIGHBORHOOD MAP	DJ SOUTH INFILDE GATHERING, LLC ATTN: AMANDA MARTIN 1600 BROADWAY, SUITE 2400 DENVER, CO 80202 PHONE (720) 381-2955	 CIVIL ENGINEERING LAND SURVEYING	10333 E. Dry Creek Rd. Suite 240 Englewood, CO 80112 Tel: (720) 482-9526 Fax: (720) 482-9546	Revisions		
	No.	Date	Init.	Appr.					Date		
	3	09/19/21	KRW								
	2	09/16/21	KRW								
GRANDE NORTH LATERAL											
RUSH NORTH LATERAL											
COTTONWOOD CREEK NORTH LATERAL, & SPINE G SOUTH DIAMETER ADJUSTMENT											

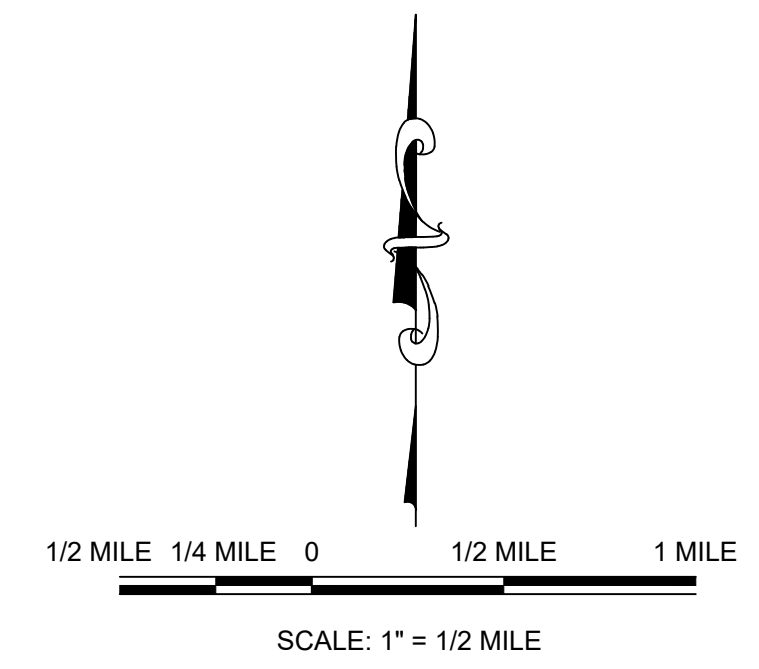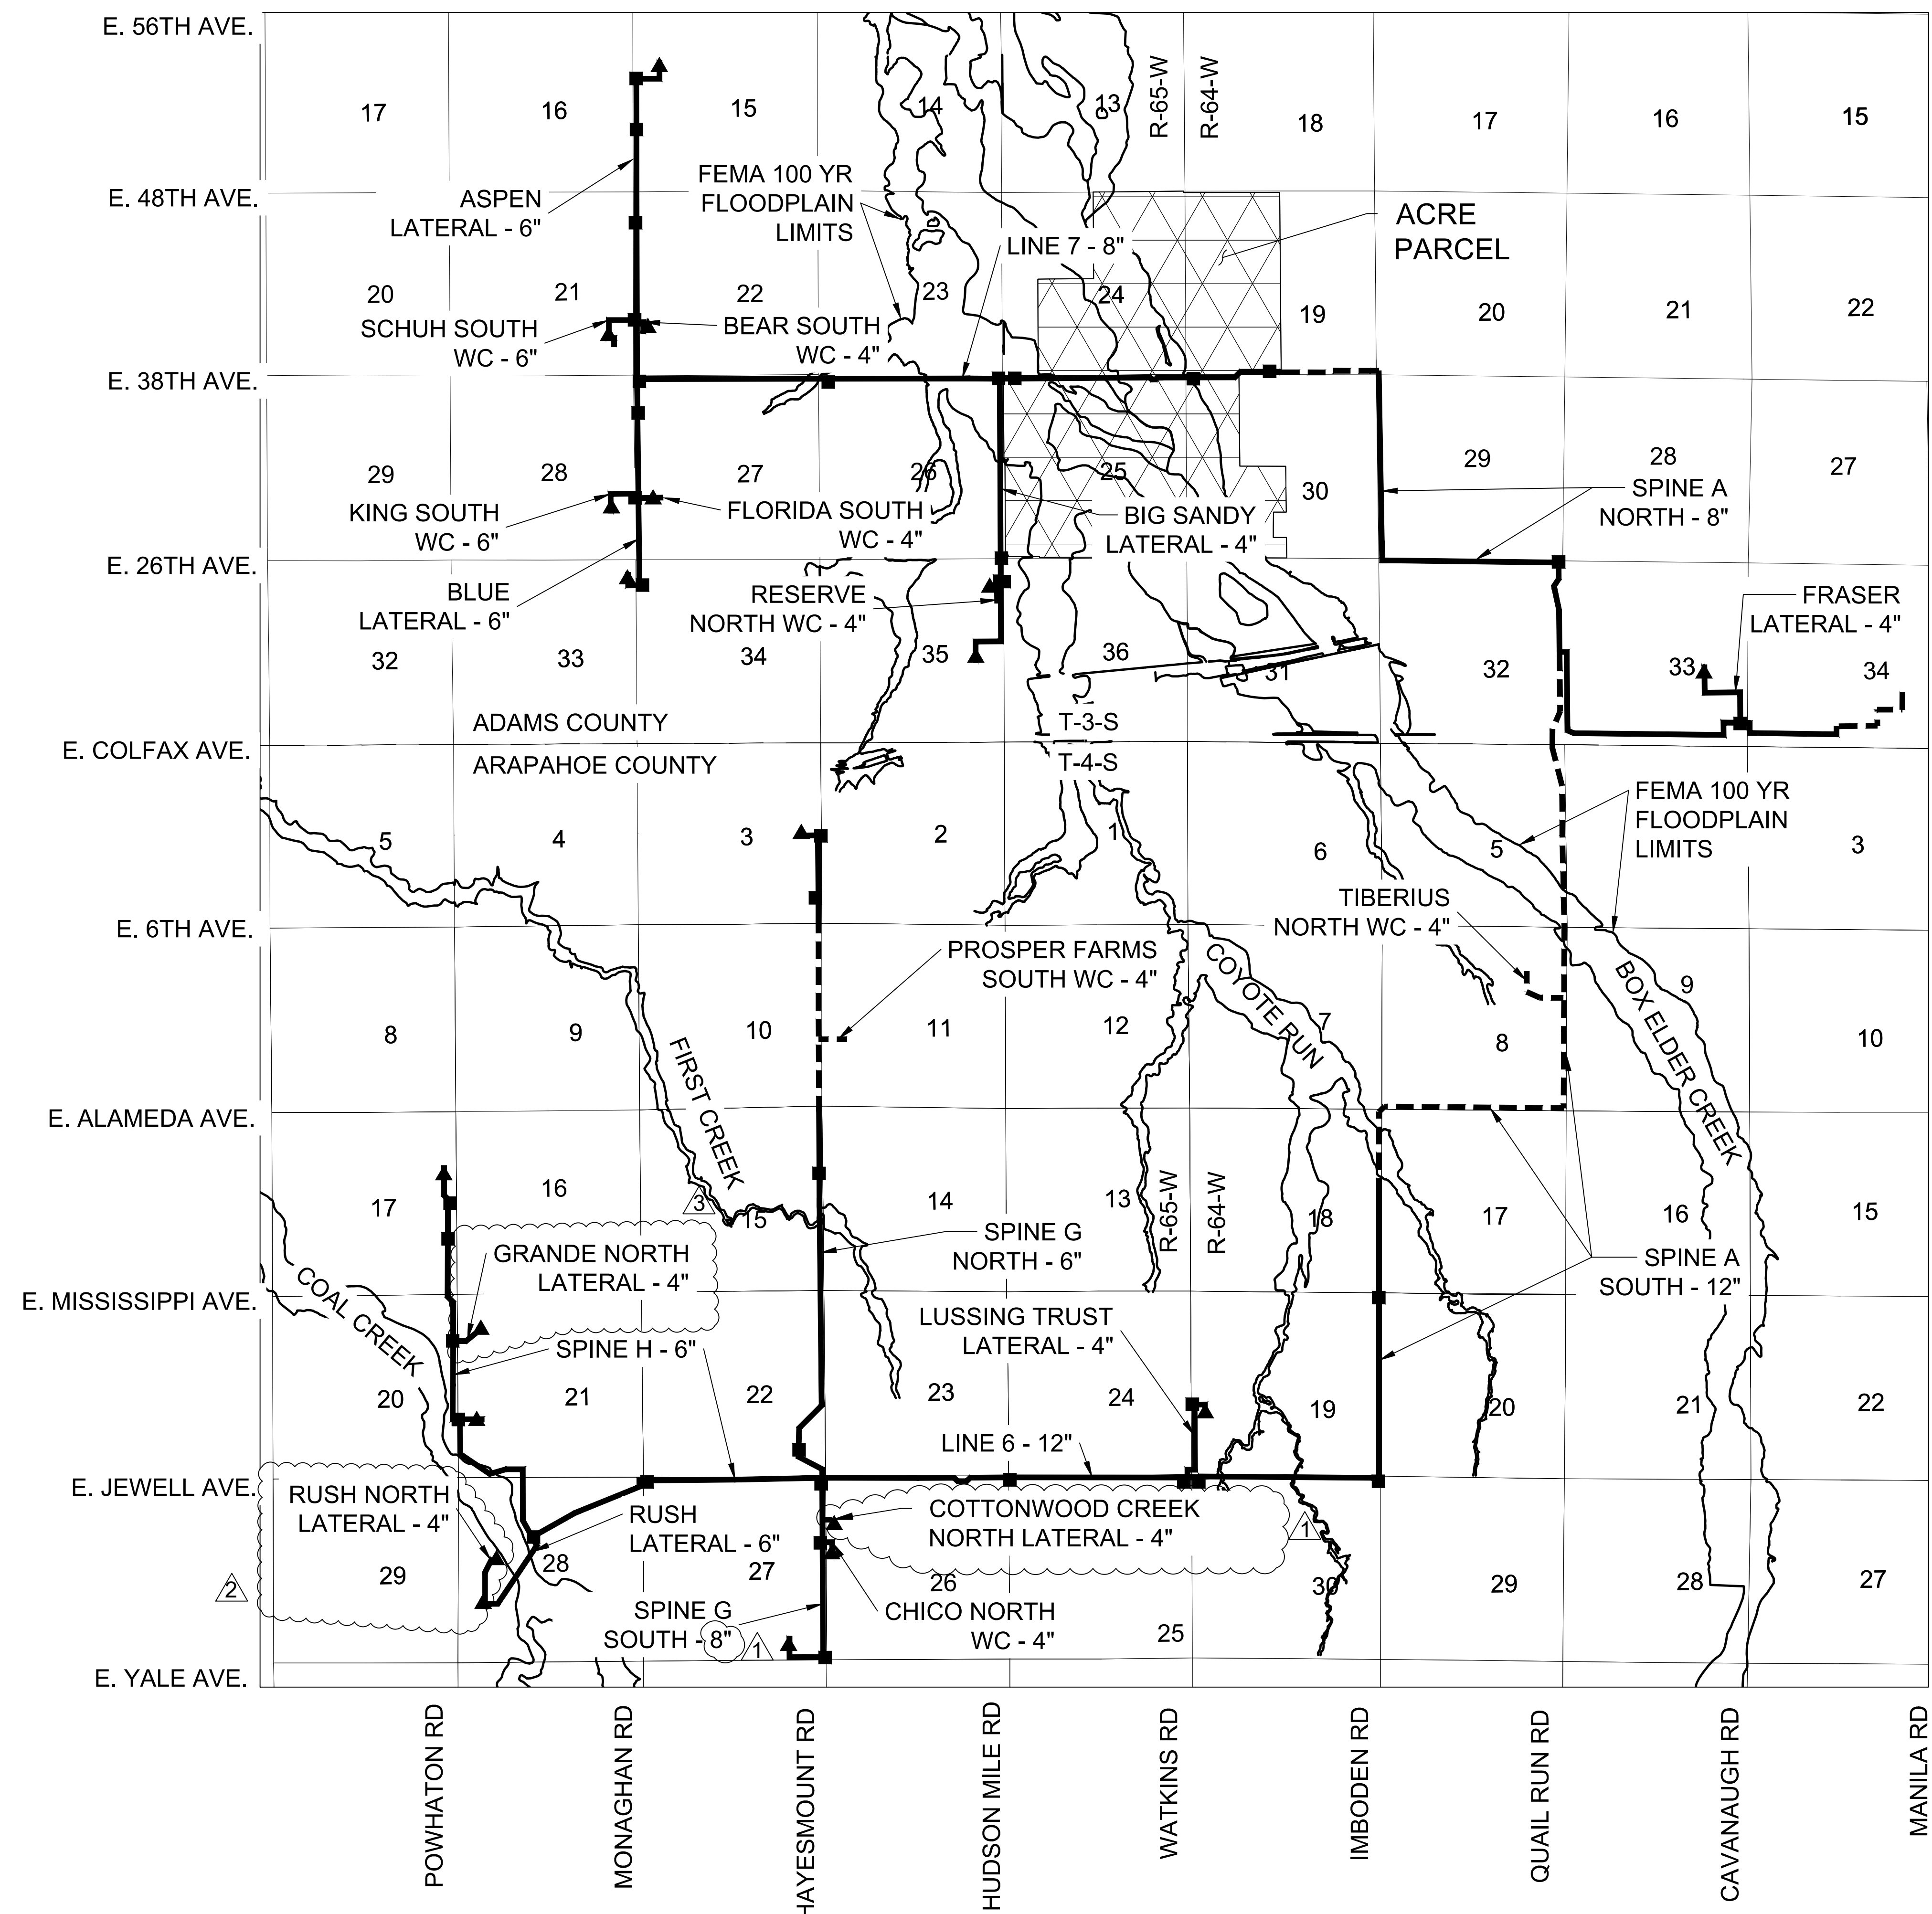

- LEGEND**
- ABOVE GROUND APPURTENANCE SITE LOCATIONS WITHIN CITY OF AURORA
 - ▲ PAD APPURTENANCE SITE LOCATIONS WITHIN CITY OF AURORA
 - PIPELINE WITHIN CITY OF AURORA LIMITS
 - - - PIPELINE OUTSIDE CITY OF AURORA LIMITS






ABOVE GROUND APPURTENANCE EQUIPMENT EXAMPLE
(SEE SHEETS 49-53 FOR APPURTENANCE EQUIPMENT DETAILS)


- SITE PLAN NOTES:**
1. THE GATHERING SYSTEM WILL NOT HAVE ANY UNDUE ADVERSE EFFECTS ON EXISTING AND FUTURE DEVELOPMENT OF THE SURROUNDING AREA AS SET FORTH IN APPLICABLE CITY MASTER PLANS. THE DESIGN OF THE PROPOSED GATHERING SYSTEM MITIGATES NEGATIVE IMPACTS ON THE SURROUNDING AREA TO THE GREATEST EXTENT FEASIBLE. THE DISTURBED AREA SHALL BE MAINTAINED DURING CONSTRUCTION BY THE APPLICANT OR PROPERTY OWNER IN SUCH A MANNER TO CONTROL SOIL EROSION, DUST AND THE GROWTH OF NOXIOUS WEEDS.
 2. ALL AMENDMENTS TO THIS SITE PLAN SHALL UTILIZE EASEMENTS THAT DO NOT SIGNIFICANTLY ENCUMBER CURBSIDE LANDSCAPING OR STREET FRONTAGE LANDSCAPE BUFFERS FOR FUTURE DEVELOPMENTS. THIS CAN BE DONE BY EITHER LOCATING ALL EASEMENTS OUTSIDE OF THESE IDENTIFIED AREAS OR INCLUDING EASEMENT LANGUAGE THAT ALLOWS SUFFICIENT PLANTINGS (AS DETERMINED BY THE CITY LANDSCAPE ARCHITECT) TO BE INSTALLED WITHIN EASEMENTS.

CALL 811
TWO WORKING DAYS
BEFORE YOU DIG
1-800-922-1987

UNCC
UTILITY NOTIFICATION
CENTER OF COLORADO

SHEET NUMBER	4	DRAWN BY: KRW	CHECKED BY: MEL	DATE: 06/22/20	SCALE: AS SHOWN	FILE NO: 8.13.0325701	CRUDE OIL PIPELINE DU SOUTH INFILTRATION GATHERING LLC CITY OF AURORA SITE PLAN APPURTENANCE SITE & FEMA FLOODPLAIN MAP	DU SOUTH INFILTRATION GATHERING, LLC ATTN: AMANDA MARTIN 1600 BROADWAY, SUITE 2400 DENVER, CO 80202 PHONE: (720) 381-2955	 CONSULTANTS CIVIL ENGINEERING LAND SURVEYING	10333 E. Dry Creek Rd. Suite 240 Englewood, CO 80112 Tel: (720) 482-9526 Fax: (720) 482-9546	Revisions		
											No.	Date	Appr.
											1	09/17/24	KRW
											2	09/18/24	KRW
											3	09/19/24	KRW

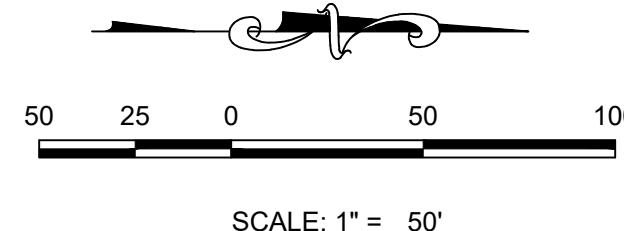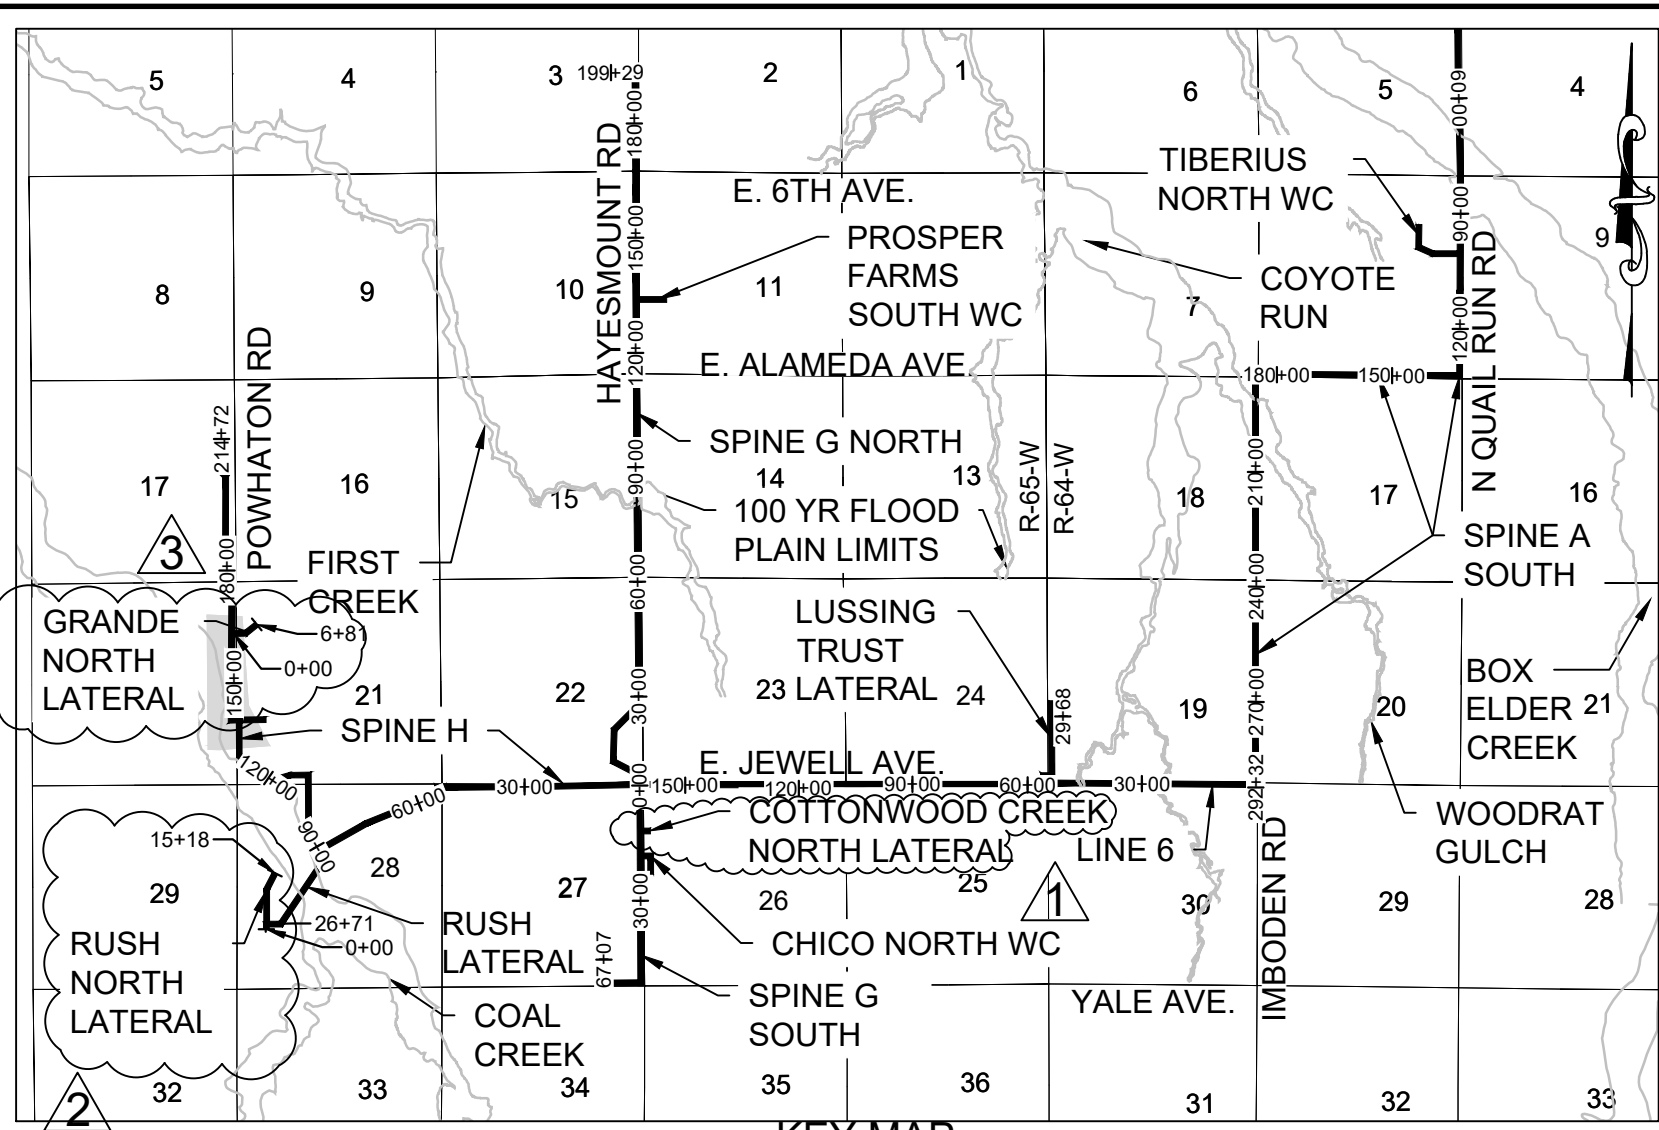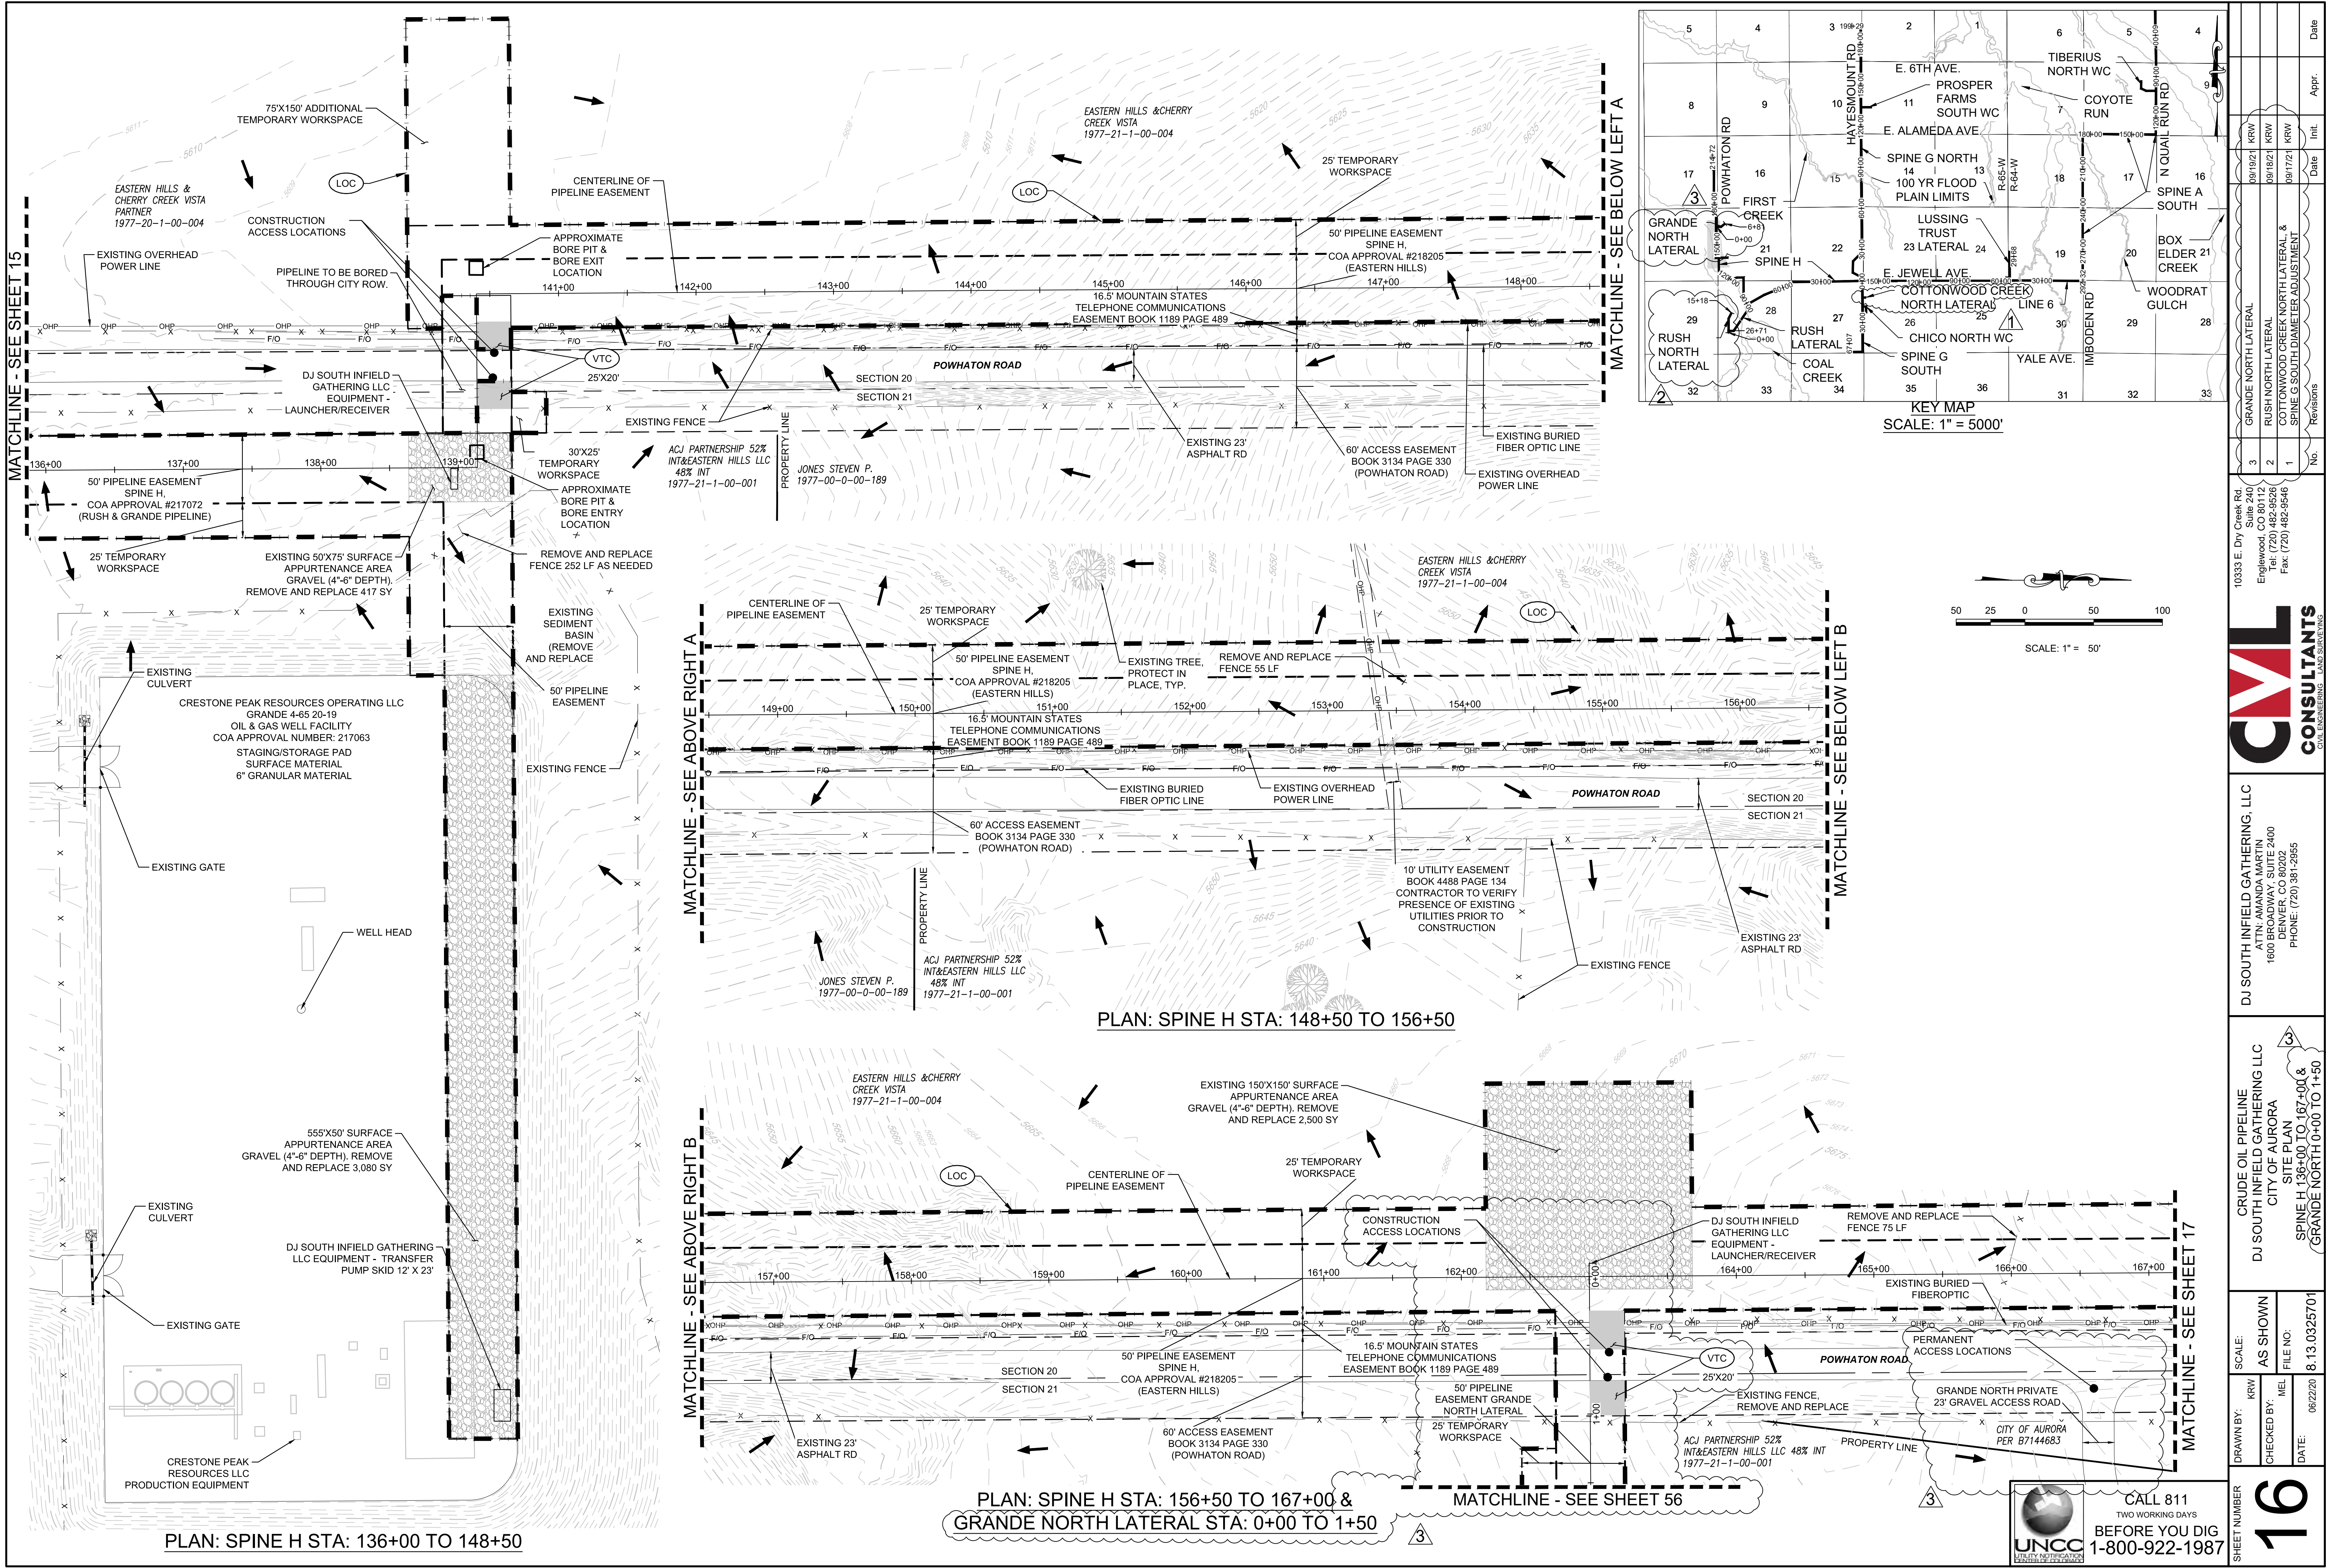

SHEET NUMBER <div>16</div>	DRAWN BY: KRW	SCALE: AS SHOWN	CRUDE OIL PIPELINE DJ SOUTH INFELD GATHERING LLC CITY OF AURORA SITE PLAN SPINE H 136+00 TO 167+00 & GRANDE NORTH 0+00 TO 1+50	DJ SOUTH INFELD GATHERING, LLC ATTN: AMANDA MARTIN 1600 BROADWAY, SUITE 2400 DENVER, CO 80202 PHONE: (720) 381-2955	 CONSULTANTS CIVIL ENGINEERING LAND SURVEYING	10333 E. Dry Creek Rd. Suite 240 Englewood, CO 80112 Tel: (720) 482-9526 Fax: (720) 482-9546			
	CHECKED BY: MEL	FILE NO: 8.13.0325701							
	DATE: 06/22/20								
Revisions									
No.	Date	Appr.							
1	09/17/21	KRW	SPINE G SOUTH DIAMETER ADJUSTMENT						
2	09/18/21	KRW	COTTONWOOD CREEK NORTH LATERAL &						
3	09/19/21	KRW	GRANDE NORTH LATERAL						

CALL 811
TWO WORKING DAYS
BEFORE YOU DIG
1-800-922-1987

UNCC
UTILITY NOTIFICATION
CENTRAL COLORADO

