



7777 CENTER AVENUE, SUITE 500
HUNTINGTON BEACH, CA 92647
PHONE: 714.596.9960
FAX: 714.596.9970
www.lazydogrestaurants.com

THESE DRAWINGS PREPARED BY LAZY DOG RESTAURANTS FOR THIS PROJECT ARE FOR USE SOLELY WITH RESPECT TO THIS PROJECT AND UNLESS OTHERWISE PROVIDED LAZY DOG RESTAURANTS SHALL BE DEEMED THE AUTHOR OF THESE DOCUMENTS AND SHALL RETAIN ALL COMMON LAW STATUTORY AND OTHER RESERVED RIGHTS INCLUDING COPYRIGHT. THESE DRAWINGS SHALL NOT BE USED BY OTHERS ON OTHER PROJECTS, FOR ADDITIONS TO THIS PROJECT OR FOR COMPLETION OF THIS PROJECT BY OTHERS, EXCEPT BY AGREEMENT IN WRITING BY LAZY DOG RESTAURANTS.

| |
|----------------------------|
| PROGRESS PRINT |
| PLAN CHECK |
| BID SET |
| CONSTRUCTION |
| 1 MINOR SP AMEND. - 3/1/18 |
| 2 |
| 3 |
| 4 |
| 5 |

Lazy Dog

EAT - DRINK -


Lazy Dog Restaurant & Bar
At Southlands
Contextual Site Plan Amendment

SHEET TITLE

SITE PLAN


DRAWN BY
CHECKED BY
SCALE
JOB NO.
SHEET NUMBER

3

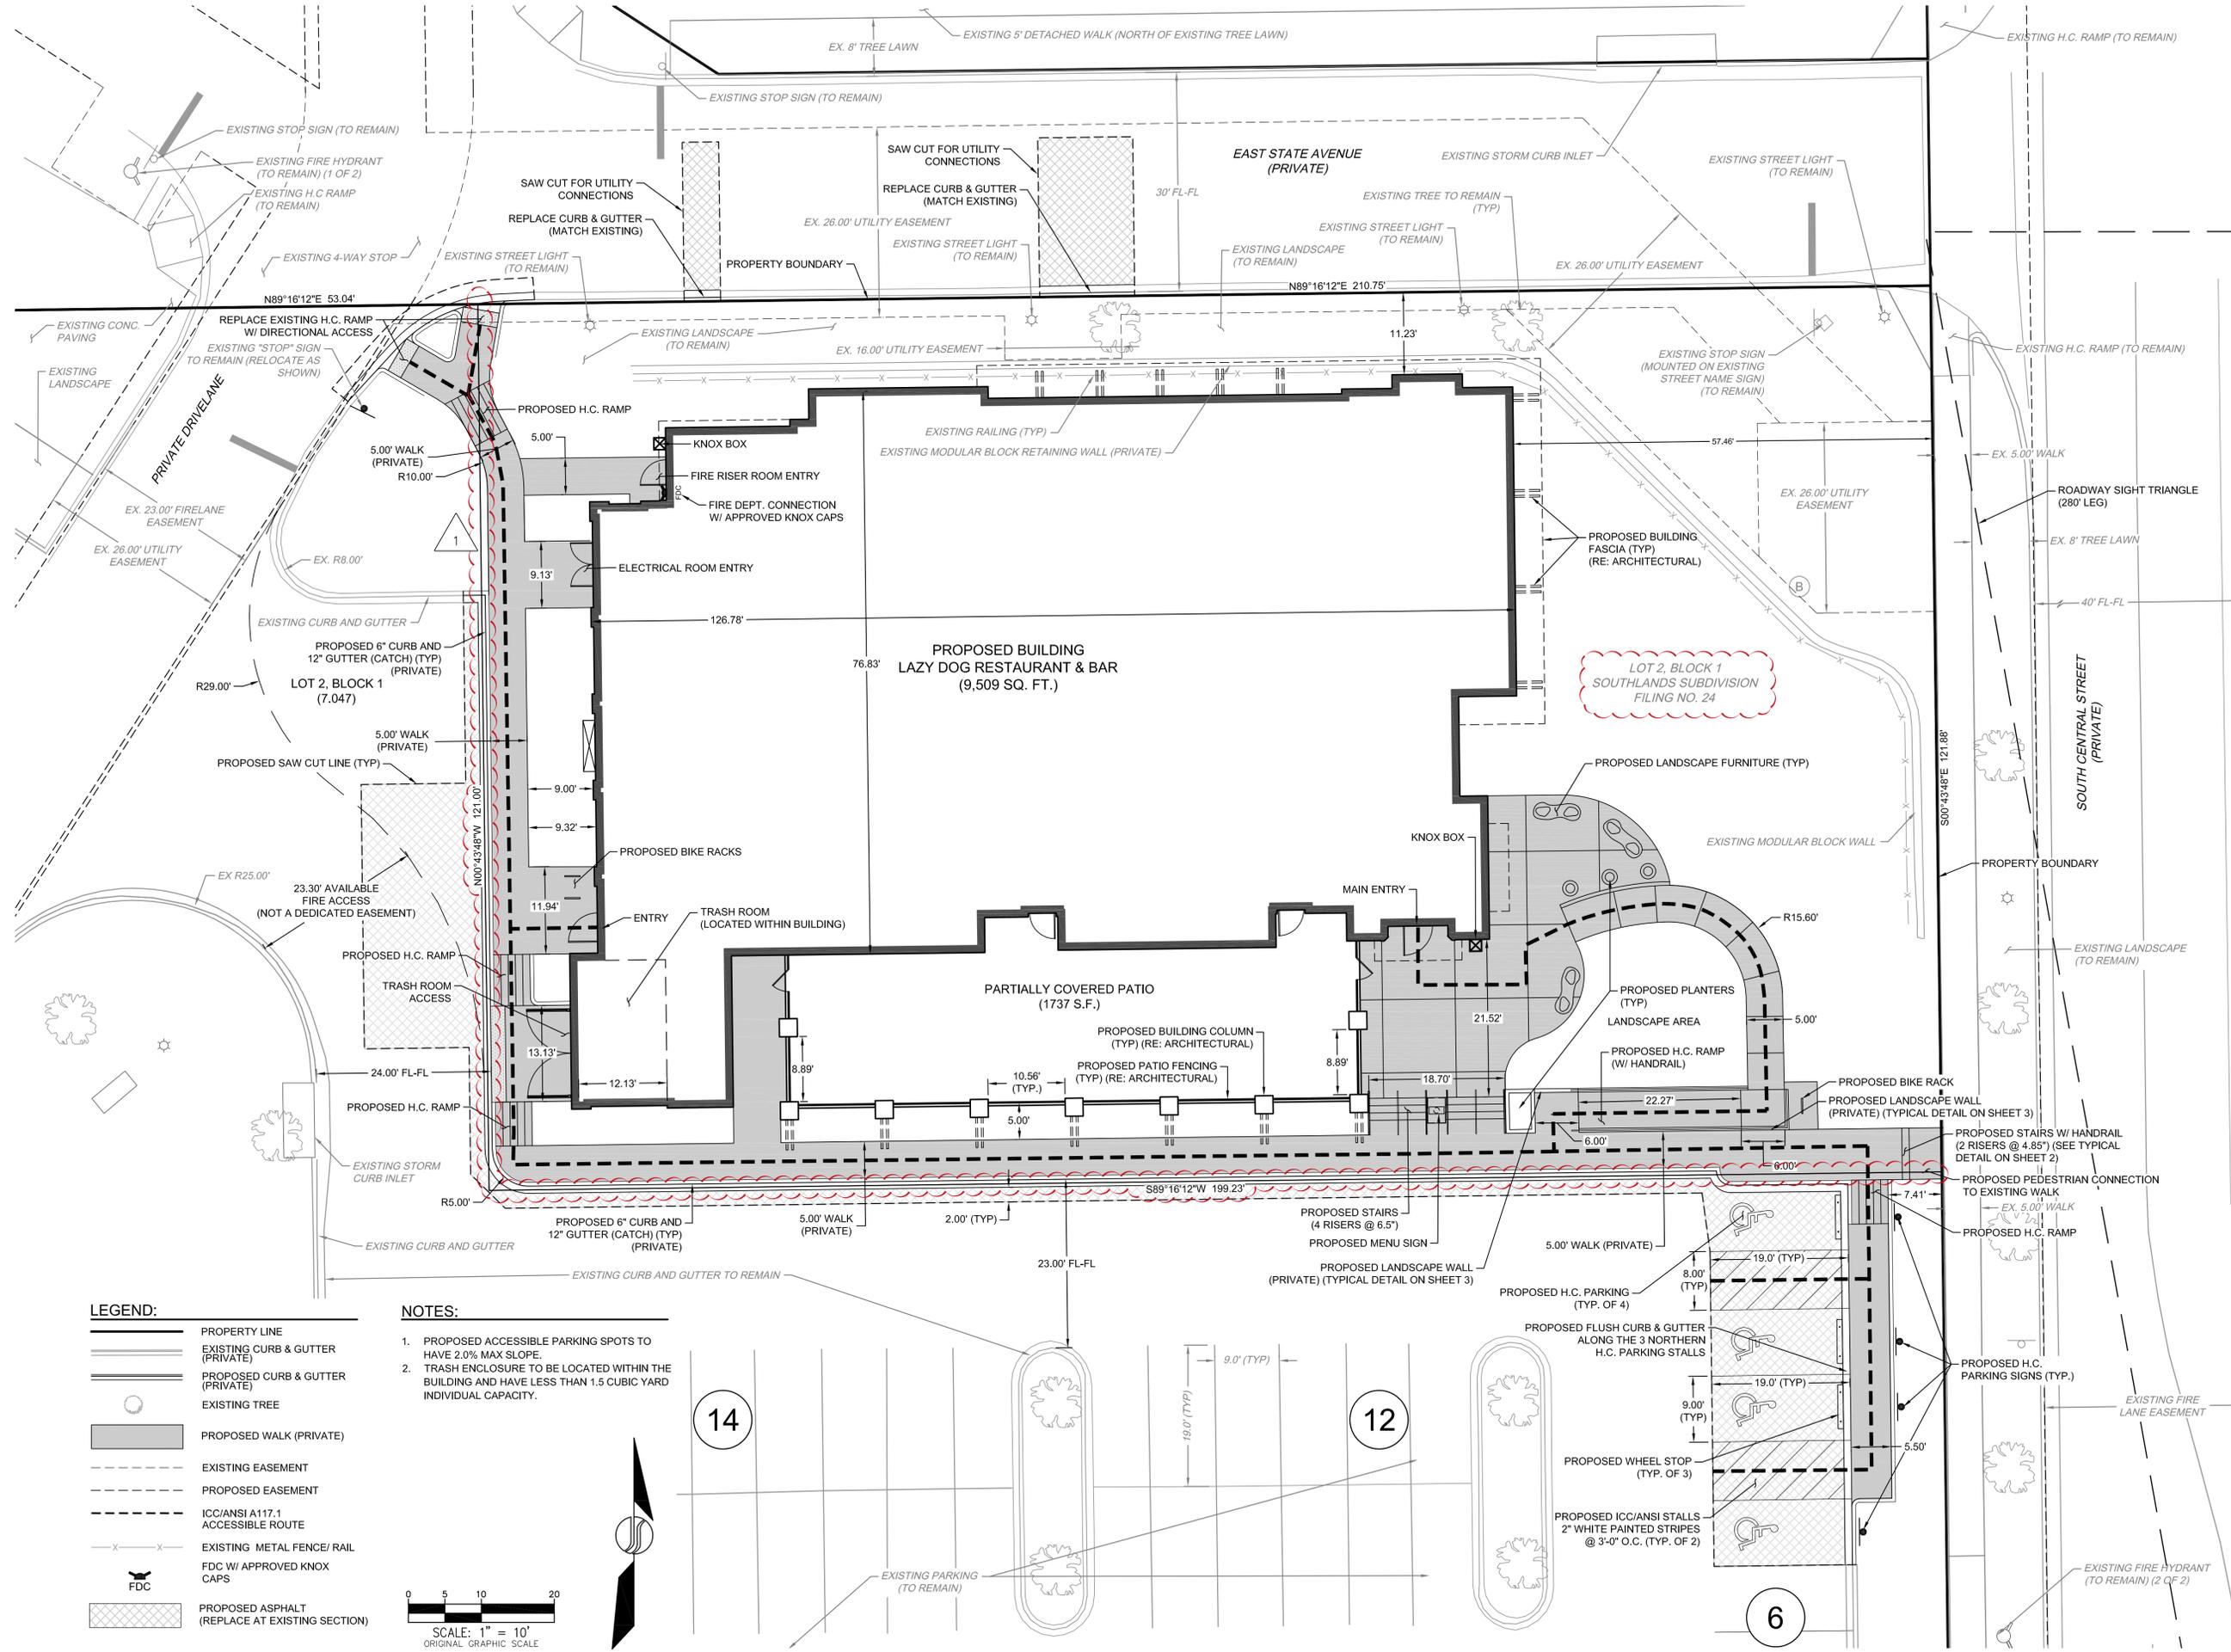

- LEGEND:**
- PROPERTY LINE
 - EXISTING CURB & GUTTER (PRIVATE)
 - PROPOSED CURB & GUTTER (PRIVATE)
 - EXISTING TREE
 - PROPOSED WALK (PRIVATE)
 - - - EXISTING EASEMENT
 - - - PROPOSED EASEMENT
 - - - ICC/ANSI A117.1 ACCESSIBLE ROUTE
 - - - EXISTING METAL FENCE/ RAIL
 - ⊠ FDC W/ APPROVED KNOX CAPS
 - ▨ PROPOSED ASPHALT (REPLACE AT EXISTING SECTION)

- NOTES:**
1. PROPOSED ACCESSIBLE PARKING SPOTS TO HAVE 2.0% MAX SLOPE.
 2. TRASH ENCLOSURE TO BE LOCATED WITHIN THE BUILDING AND HAVE LESS THAN 1.5 CUBIC YARD INDIVIDUAL CAPACITY.

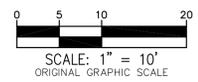

14

12

6