



City of Aurora Planning Department
 15151 E Alameda Pkwy, 2nd Floor
 Aurora, Colorado 80012
 (303) 739-7250

Case Mgr KS
 Case Number 2010 4003 00
 Quarter Section 04D
 Row ID 541766

CO-DEN 1242B

MINOR AMENDMENT APPLICATION FORM

Available online at www.aurora.gov > Departments > Planning Department > Application Forms & Instructions: **Last revised on: 01/12/10**

Applicant Information

Enter information for the person who will answer any questions regarding the application.

Name Jane Chipman Clearwine
 Address 0346 E. Mississippi Ave
Denver, CO 80224
 Phone 720.425.2775 Fax N/A
 Email jane@siteproperty.com

Property Owner

Enter information for the entity or person who is listed with the county as the owner of record.

Name Yosef Lutwak
 Address 1945 Peoria St #107
Aurora, CO 80010
 Phone _____ Fax _____
 Email _____

Type of Application

- Site Plan Amendment Site Plan Amend & Extend
 Redevelopment Plan New House Model
 Parking Plan Other: _____

Property Information

Address 1945 Peoria St #107
 Existing Use _____

Proposed Changes

installation of an electric cabinet
installation of panel antenna
= MW dishes.

Submittal Materials

Three copies collated and folded down to 8½" x 11" are required. All plans should show redline changes to scale on existing drawings obtained from the Planning Department.

- Site Plan Building Elevation(s)
 Landscape Plan Detail Drawing(s)
 Color Photographs _____
 Copy of Current Business License

Property Owner's Signature

If a Minor Amendment is approved, I agree to amend the original Site Plan Mylar or provide a new Mylar to reflect the approved changes within 30 days of the approval date. An original signature is required.

see attached
 Property Owner's Signature _____ Date _____

Notice to Applicants: Use this form to apply for Minor Amendments to existing Site Plans, for minor Redevelopment Plans where no Site Plan was originally required, for Parking Plans, and for approval of new house models. Your fee in the form of a check or money order must accompany the application. Be sure to meet with a Planning Department representative prior to submitting the application. Hard to read faxed applications will not be accepted.

This Section for City Use Only

Site Plan Clearwine CMRS @1945 Peoria
 Planning Dept Use Code CMRS
 Description Install antennas below parapet of existing building. Equipment inside building.
 General Location _____
 Existing Zoning FBAD-1 List all Wards I
 Neighborhood Liaison Cannon
 Date of Pre-submittal meeting _____ by _____
 Date application received 6/3/2010 by KS
 Thursday application start date _____
 Amount of application fee paid \$516 (1-2 Sheets)
 \$777 (3-5 Sheets) \$1339 (Filed After Construction)

Real Property Review
 Required Not Required
 No Encroachment Easement encroachment

(See opposite side for additional referrals)

Planning Department Action

- Approved Approved w/conditions
 Denied Withdrawn Closed as Inactive
 Referred to Planning Commission

[Signature] 6-7-10
 Signed: Director of Planning or Representative Date

Conditions/Notes

 Date File Retired _____ Submissions _____

June 3rd, 2010

City of Aurora Planning Department

15151 Alameda Parkway

Aurora, Colorado 80012

Attn: David Barrett

Subject: Submittal letter for co-location request of telecommunication equipment at 1945 Peoria Street

Mr. Barrett,

Attached through this letter is a request for review and approval of a proposal to co-locate telecommunication equipment on the existing rooftop located at 1945 Peoria Street. The applicant for this request is Clear Wireless, LLC, a telecommunications company headquartered in Kirkland, Washington. Clear Wireless provides subscription high speed, high capacity, wireless, WIFI services. At the present time Clear Wireless is designing and constructing a system involving several hundred facilities in the greater Denver area. This proposed site is part of the Denver Build Program. The site will be un-manned and will operate 24 hours a days.

As mentioned, the site contains an existing rooftop. Clear Wireless is proposing to attach 3 panel antennas and 3 microwave dishes to this rooftop. The proposed antennae are approximately 60" x 8" x 5" in size. The three microwave dishes are for the facility's "back haul" connection..

Electrical equipment will consist of one steel cabinet approximately 4' x2' x3' in size (comparable to a small refrigerator.) The cabinet will be mounted "open air" on a raised 3' x 6' steel mesh platform. This platform in turn will be located in the existing basement of the building on the east side.

Should the staff have any questions concerning this request or need additional information, please do not hesitate to contact me at jane@siteproperty.com (720-425-2775.)

Sincerely,

Jane Chipman

A handwritten signature in cursive script that reads "Jane Chipman". The signature is written in black ink and is positioned to the right of the typed name.

Letter of Authorization

Clear Wireless Site ID: CO-DEN1242

I Yosef Lutwak / AR RLLP _____ hereby authorize Clear Wireless LLC to make application for a wireless facility to be located on the property located at: **1945 Peoria Street, Aurora, CO 80010**

Authorization to make application for land use review and/or building permit shall not be construed to constitute an agreement to lease. No construction shall commence before a lease is executed.

Sincerely,



Signature

Print Name: Yosef Lutwak / AR RLLP _____ Date: 5/24/2010 _____
(Tower/Building Owner or Authorized Agent)

(Tower/Building Owner or Authorized Agent) Mailing Address: 1945 Peoria St # 107

Aurora, CO 80010 _____

PROPOSED CLEARWIRE
(1) PANEL ANTENNAS +
(1) BACKHAUL ANTENNA
FLUSH MOUNTED TO
BUILDING WALL AND PAINTED
TO MATCH

PROPOSED CLEARWIRE
(1) PANEL ANTENNAS +
(1) BACKHAUL ANTENNA
FLUSH MOUNTED TO
BUILDING WALL AND PAINTED
TO MATCH

COPYRIGHT 2010



ALLPRO
CONSULTING GROUP, INC.
CIVIL & STRUCTURAL CONSULTANTS
972-231-8893
www.allprogrp.com
ACGI JOB# 10-1535

CO-DEN1242B
1945 PEORIA ST.
AURORA, CO 80010



CLEAR WIRELESS SITE NUMBER
CO-DEN1242B

STRUCTURE TYPE: ROOFTOP

APPROVED FOR CONSTRUCTION

NETWORK DEPLOYMENT

RF

BACK HAUL

SITE ACQUISITION

PROPERTY OWNER

DRAWING INDEX

REV.

DIRECTIONS

DEPART DENVER INTERNATIONAL AIRPORT ON PENA BLVD 0.2 MI
KEEP RIGHT TO STAY ON PENA BLVD 9.5 MI I-70 / RENTAL CAR RETURN / AIRPORT EXIT
AT EXIT 1A, TAKE RAMP (LEFT) ONTO I-70 [US-36] 1.6 MI
AT EXIT 282, TURN RIGHT ONTO RAMP 0.3 MI I-225 / COLO SPGS / PEORIA ST / AURORA
TAKE RAMP (LEFT) ONTO I-225 2.4 MI I-225 / AURORA / COLORADO SPRINGS
AT EXIT 10, TURN RIGHT ONTO RAMP 0.3 MI US-40 / US-287 / COLFAX AVENUE
TURN RIGHT (WEST) ONTO I-70 BUS [US-287] 1.1 MI
TURN RIGHT (NORTH) ONTO PEORIA ST 0.4 MI
ARRIVE 1945 PEORIA ST, AURORA, CO 80010

- T-1 TITLE SHEET
- Z-1 ZONING
- A-1 SITE PLAN
- A-1A ELEVATION

- 0
- 0
- 0
- 0

VICINITY MAP



PROJECT SUMMARY



SCOPE OF WORK: PROPOSED SECTOR ANTENNAS & BACKHAUL ANTENNAS MOUNTED ON AN EXISTING ROOF TOP. EQUIPMENT CABINET WILL BE LOCATED ON ROOF INSIDE ROOFTOP UTILITY ROOM. SITE IS AN UNMANNED TELECOMMUNICATIONS FACILITY.

SITE NUMBER: CO-DEN1242B
SITE ADDRESS: 1945 PEORIA ST. AURORA, CO. 80010
PROPERTY OWNER: ARR RLLP
CONTACT: ROSIE IBARRA (303) 360-6818
SITE ACQUISITION: SITE PROPERTY COMPANY PO BOX 100104 FORT WORTH, TX 76185-0104 JONATHAN MOCK - (817) 266-2663
APPLICANT: CLEAR WIRELESS, LLC 4400 CARILLON POINT KIRKLAND, WA 98033 TEL: (425) 216-7800 FAX: (425) 216-7900
LATITUDE: 39.74640800' LONGITUDE: -104.84733800'
ZONING: RESIDENTIAL JURISDICTION: CITY OF AURORA TAX ID: 0182335401023

A&E CONSULTANT
ALLPRO CONSULTING GROUP, INC.
9221 LYNDON B JOHNSON FREEWAY, #204
DALLAS, TX 75243
OFFICE: 972-231-8893
FAX: 866-364-8375
CONTACT: RAJESH SEHGAL P.E.

UTILITY COMPANIES:
POWER: XCEL ENERGY (TEL.) (800) 481-4700

COLORADO ONE CALL:

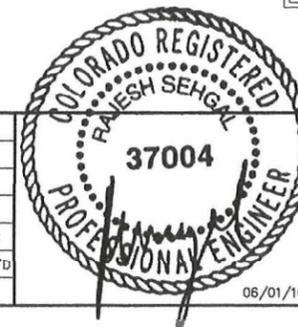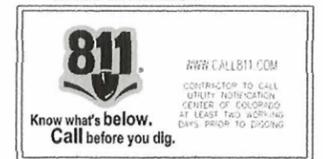

CO-DEN1242B

1945 PEORIA ST.
AURORA, CO. 80010

TITLE SHEET

NO.	DATE	REVISIONS	BY	CHK	APP'D
0	06/01/10	FINAL ZONING DRAWINGS	JR	RS	RS

SCALE: AS SHOWN DESIGNED D.ESCOBAR ACGI JOB# 10-1327

06/01/10

DRAWING NUMBER	REV
T-1	0



9221 Lyndon B Johnson Fwy
Suite 204, Dallas, TX 75243
Phone: 972-231-8893 Fax: 866-364-8375
www.allprocgi.com

CLEAR WIRELESS, LLC
4400 CARILLON POINT
KIRKLAND, WA 98033
TEL: (425) 216-7800
FAX: (425) 216-7900



FOR 24" X 36" PLOT - 1" = 50' 0 25' 50' 100'
 FOR 11" X 17" PLOT - 1" = 100'

AERIAL 1
 SCALE: 1"=100' Z-1

ALLPRO
 CONSULTING GROUP, INC.
 9221 Lyndon B Johnson Fwy
 Suite 204, Dallas, TX 75243
 Phone: 972-231-8893 Fax: 866-364-8375
 www.allprocgi.com


clear
 super fast mobile internet

CLEAR WIRELESS, LLC
 4400 CARILLON POINT
 KIRKLAND, WA 98033
 TEL: (425) 216-7600
 FAX: (425) 216-7900

CO-DEN1242B

1945 PEORIA ST.
 AURORA, CO. 80010


NO.	DATE	REVISIONS	BY	CHK	APP'D
0	06/01/10	FINAL ZONING DRAWINGS	JR	RS	RS
SCALE: AS SHOWN		DESIGNED D.ESCOBAR	ACGI JOB# 10-1327		

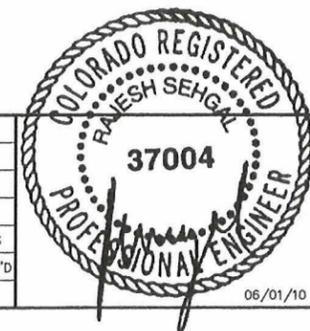

ZONING

DRAWING NUMBER	REV
Z-1	0

NOTE: STRUCTURAL ANALYSIS MUST BE PERFORMED BEFORE INSTALLATION OF NEW ANTENNAS. STRUCTURAL ANALYSIS PROVIDED BY OTHERS.

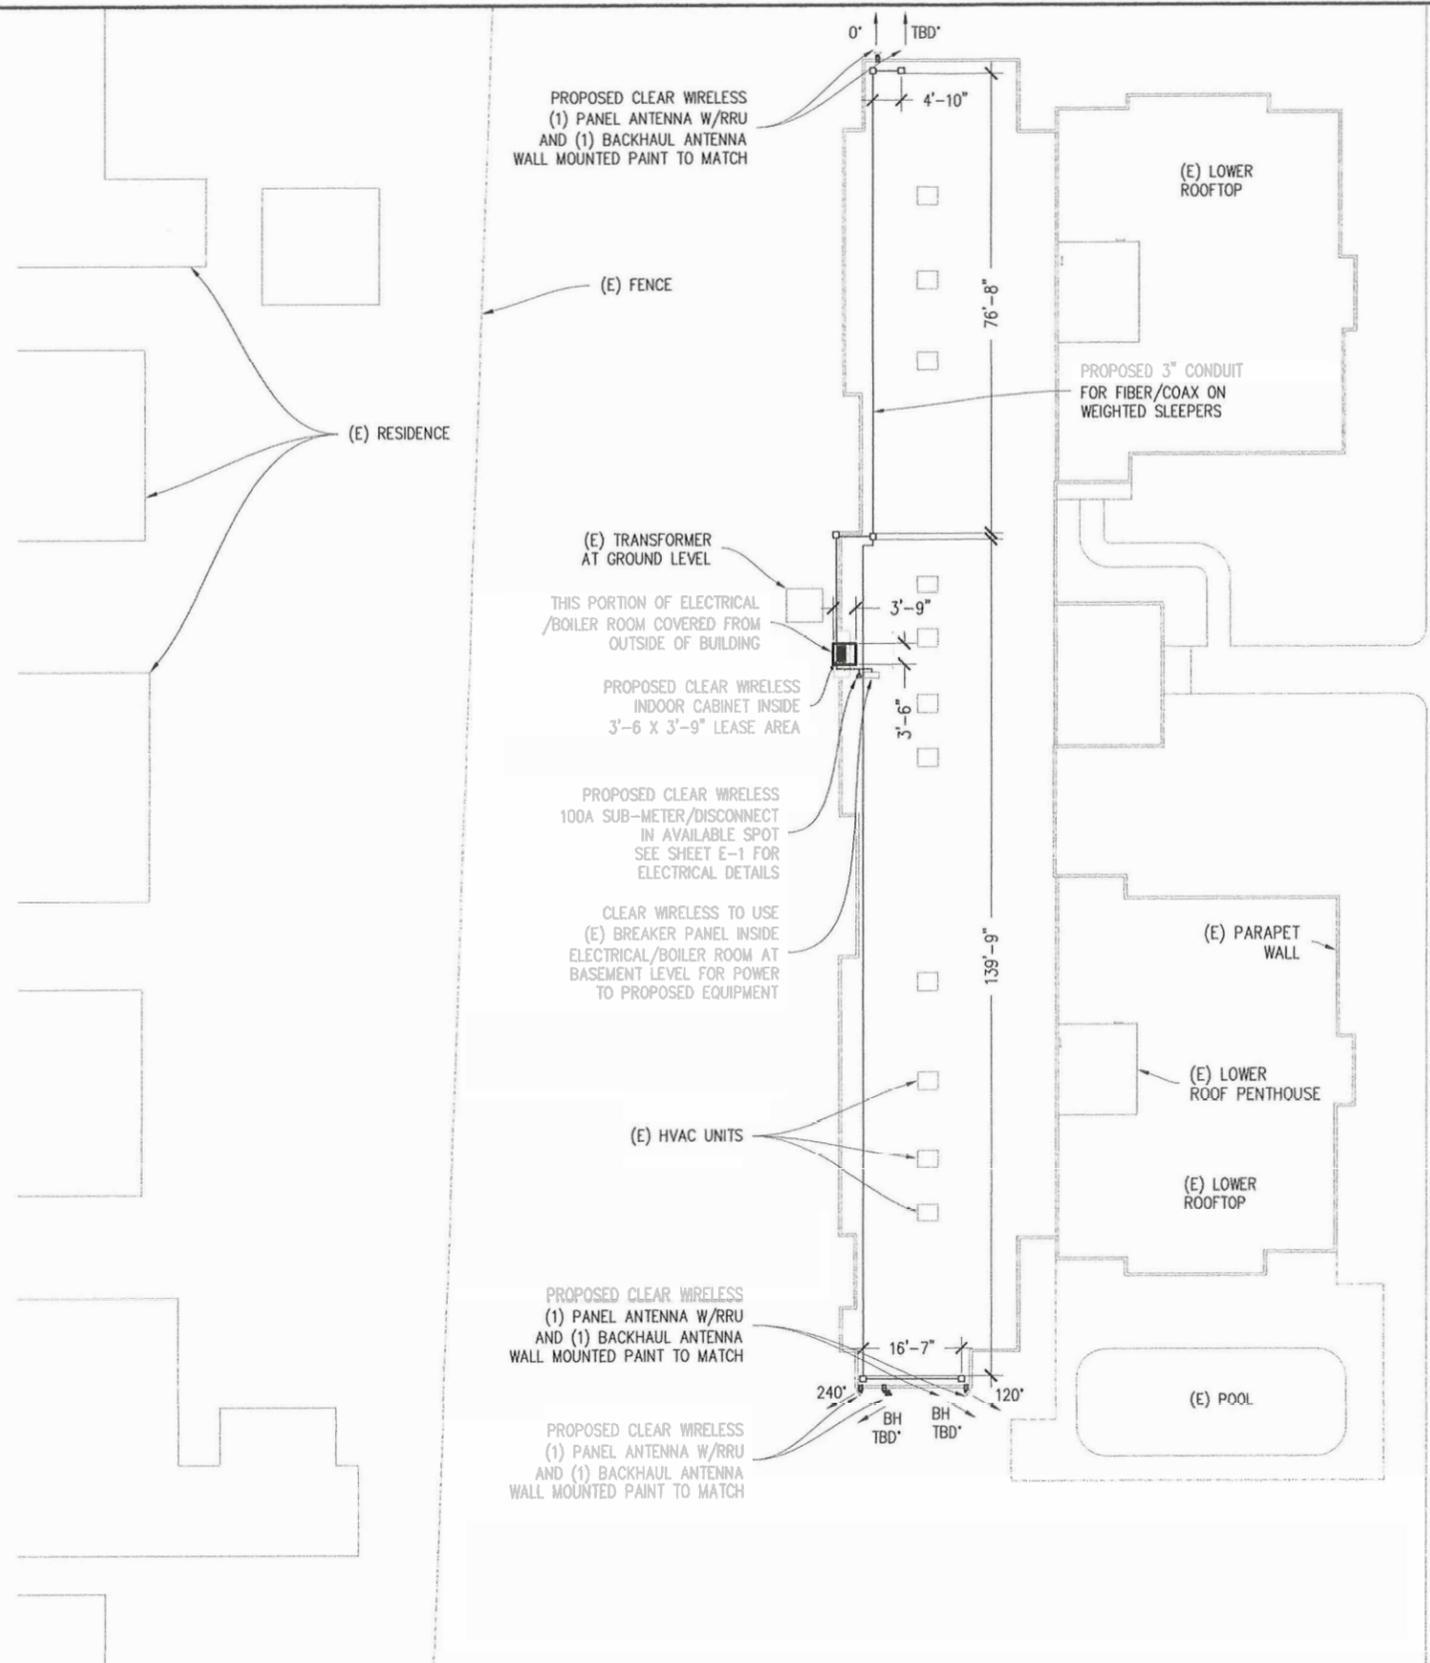

OVERALL SITE LAYOUT 1 A-1
SCALE: 1"=30'



CO-DEN1242B

1945 PEORIA ST.
AURORA, CO. 80010

NO.	DATE	REVISIONS	BY	CHK	APP'D
0	06/01/10	FINAL ZONING DRAWINGS	JR	RS	RS
SCALE: AS SHOWN		DESIGNED: D.ESCOBAR	ACGI JOB# 10-1327		06/01/10

SITE PLAN


DRAWING NUMBER: A-1
REV: 0

ALLPRO
CONSULTING GROUP, INC.
9221 Lyndon B Johnson Fwy
Suite 204, Dallas, TX 75243
Phone: 972-231-8893 Fax: 866-364-8375
www.allprocgi.com

clear
super fast mobile internet

CLEAR WIRELESS, LLC
4400 CARILLON POINT
KIRKLAND, WA 98033
TEL: (425) 216-7600
FAX: (425) 216-7900

NOTE: STRUCTURAL ANALYSIS MUST BE PERFORMED BEFORE INSTALLATION OF NEW ANTENNAS. STRUCTURAL ANALYSIS PROVIDED BY OTHERS.

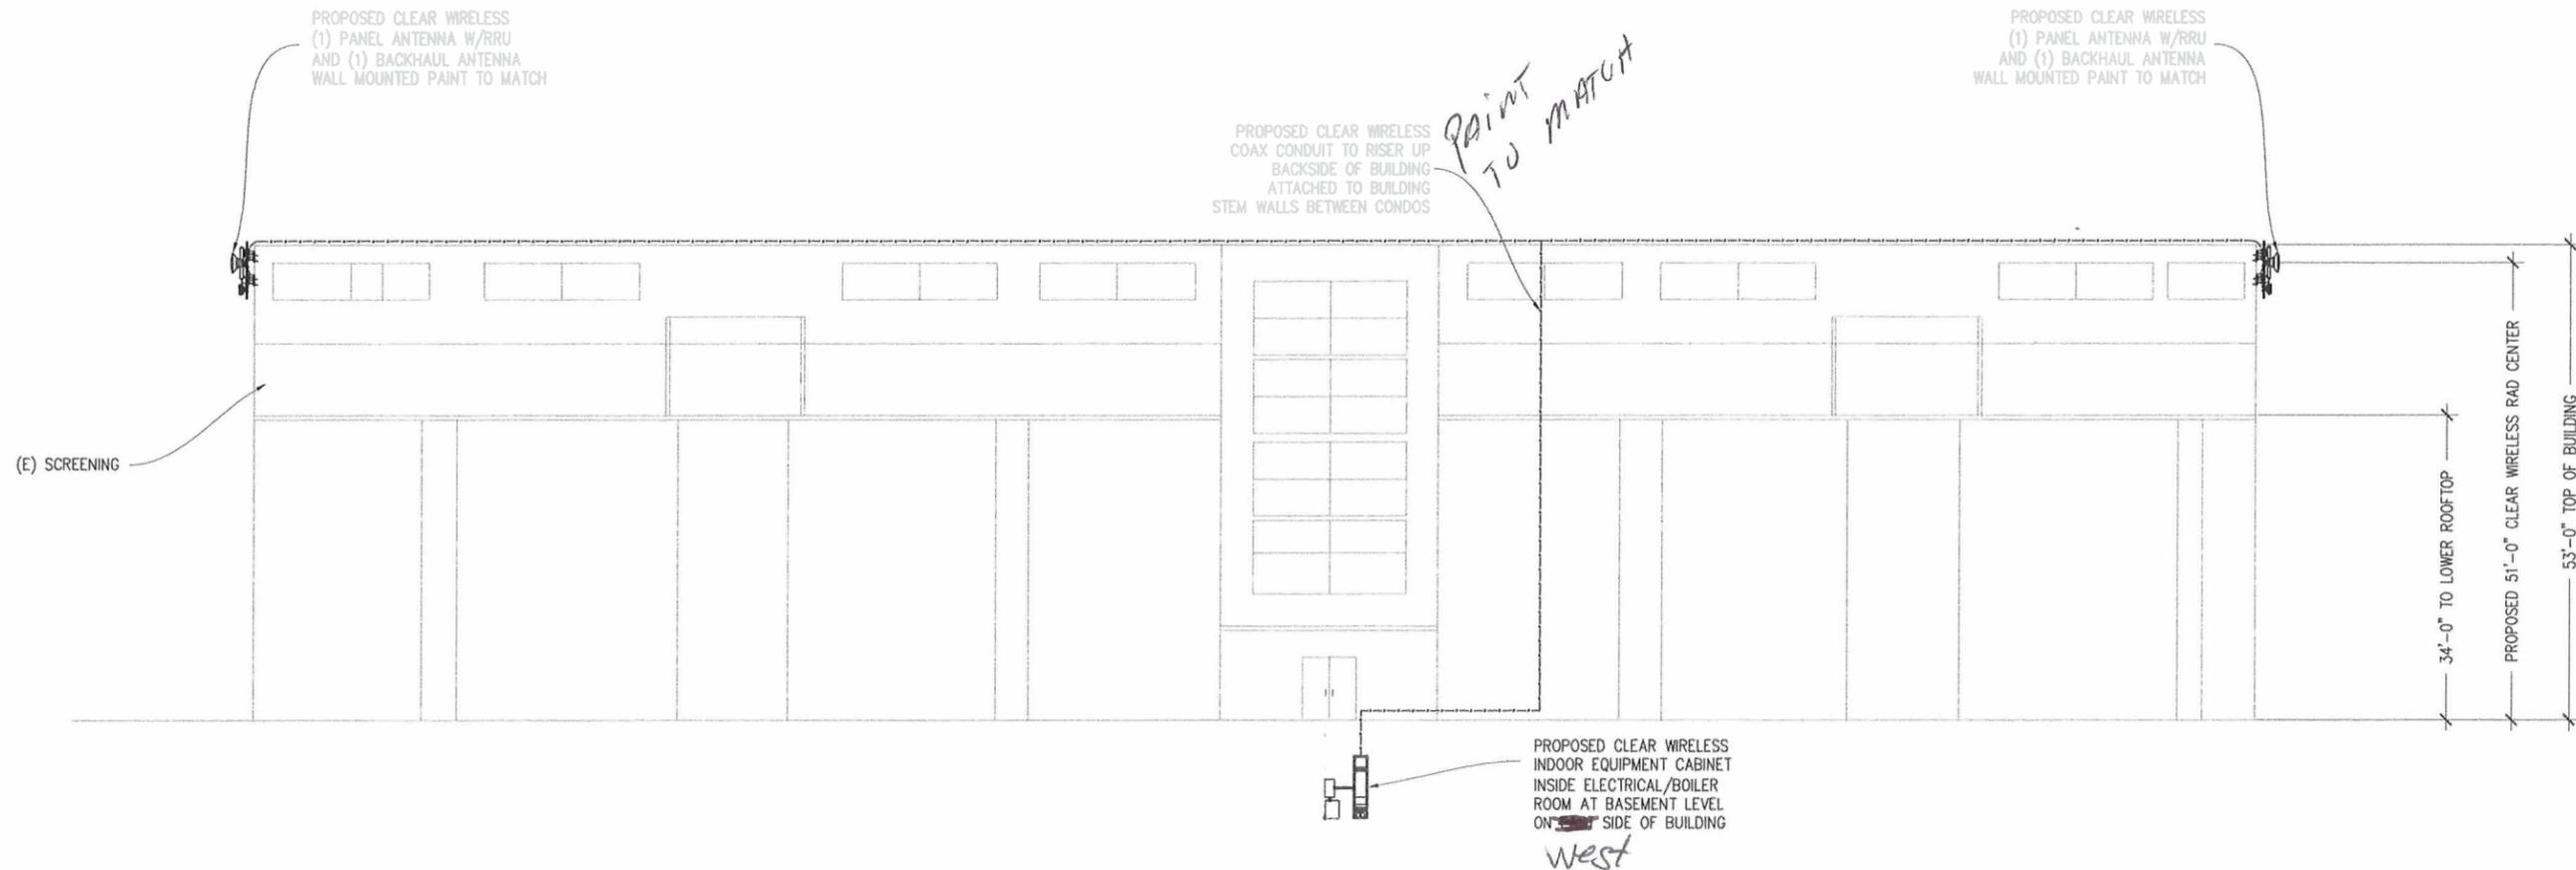

ELEVATION LOOKING WEST (1)
SCALE: 1"=20' (A-1)



ALLPRO
CONSULTING GROUP, INC.
9221 Lyndon B Johnson Fwy
Suite 204, Dallas, TX 75243
Phone: 972-231-8893 Fax: 866-364-8375
www.allprocgi.com

clear
super fast mobile internet
CLEAR WIRELESS, LLC
4400 CARILLON POINT
KIRKLAND, WA 98033
TEL: (425) 216-7800
FAX: (425) 216-7900

CO-DEN1242B

1945 PEORIA ST.
AURORA, CO. 80010

NO.	DATE	REVISIONS	BY	CHK	APP'D
0	06/01/10	FINAL ZONING DRAWINGS	JR	RS	RS
SCALE: AS SHOWN		DESIGNED D.ESCOBAR	ACGI JOB# 10-1327		

DRAWING NUMBER		REV
A-1A		0

ELEVATION

06/01/10